


TOLER RD

WILLIAMS RD
WATER IN ST. RIM

N67-38E

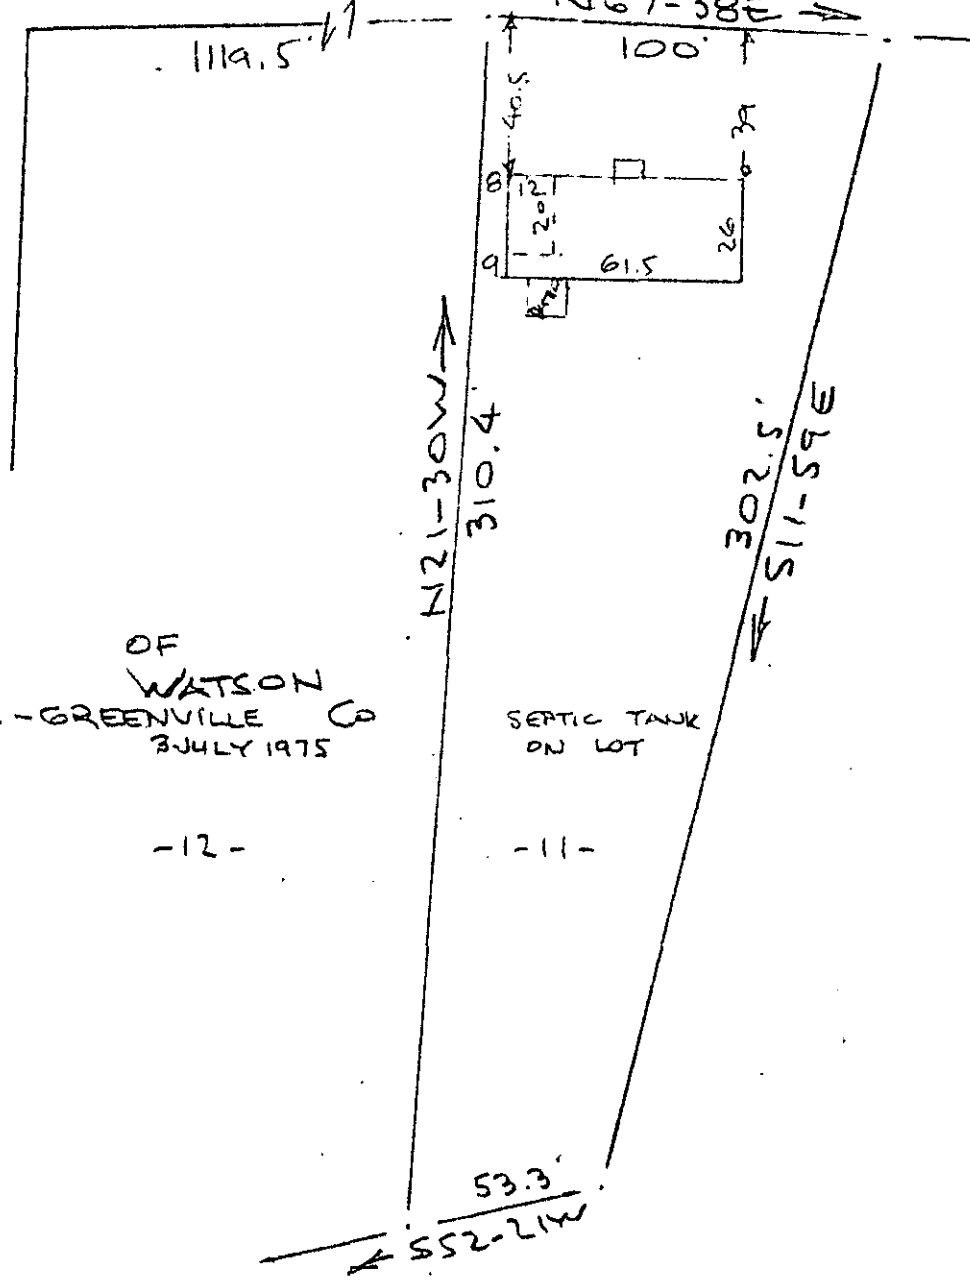


PROPERTY OF
JAMES HERBERT WATSON
TRAVELERS REST, S.C. - GREENVILLE CO
SCALE 1"=50'
3 JULY 1975

SEPTIC TANK
ON LOT

-12-

-11-

This is to certify that on the 3rd day of July 1975, I surveyed the property shown on this plat, being known as lot 11 on plat of PROPERTY OF JAMES HERBERT WATSON and recorded in the RMC Office Greenville County, S. C., in Plat Book at Page ; and that the property lines, walls and buildings are as shown hereon and that the walls and buildings located on said lot do not encroach or project on adjacent street or property and that no adjacent walls or buildings encroach or project on said premises, and no power lines cross this property except as shown hereon.

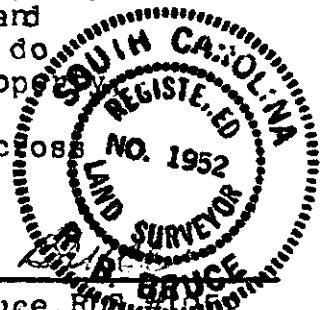

R. B. Bruce

R. B. Bruce, RMC
St.

5M-125

FILED
GREENVILLE CO. S.C.

JUL 25 4 23 PM '75

BONNIE S. TANKERSLEY
R.M.C.

2265
JUL 25 1975

CAROLINA SURVEYING CO.
112 Manly St.

Greenville, S. C.

14175