

FILED
GREENVILLE CO. S.C.
AUG 6 3 06 PM '75
DONNIE S. TANKERSLEY
R.M.C.


I hereby certify that on July 31, 1975 I surveyed the above lot as shown hereon plat recorded in plat book "40" on page 101 B and according to deed recorded in vol. 985 on page 307 in the R.M.C. Office Of Greenville County; and that the property lines, buildings, and walls are as shown hereon, that no walls or buildings encroach on adjacent streets or property, and no buildings or walls encroach or project on these premises.

PROPERTY OF
R. H. YEARGIN
IN THE CITY OF GREENVILLE
GREENVILLE COUNTY S.C.

Charles F. Webb
Charles F. Webb R.L.S.

WEBB SURVEYING & MAPPING
SCALE 1" = 40' JULY 31, 1975

15M-138 AUG 6 1975

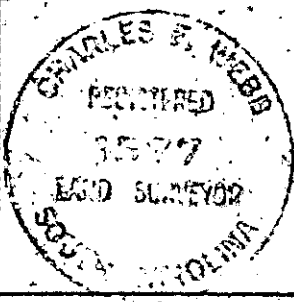

RECORDING FEE
PAID \$ 1.00

3348