


OCT 3 4 17 PM '75
DONNIE S. TANKERSLEY
R.M.C.

HODGES ST

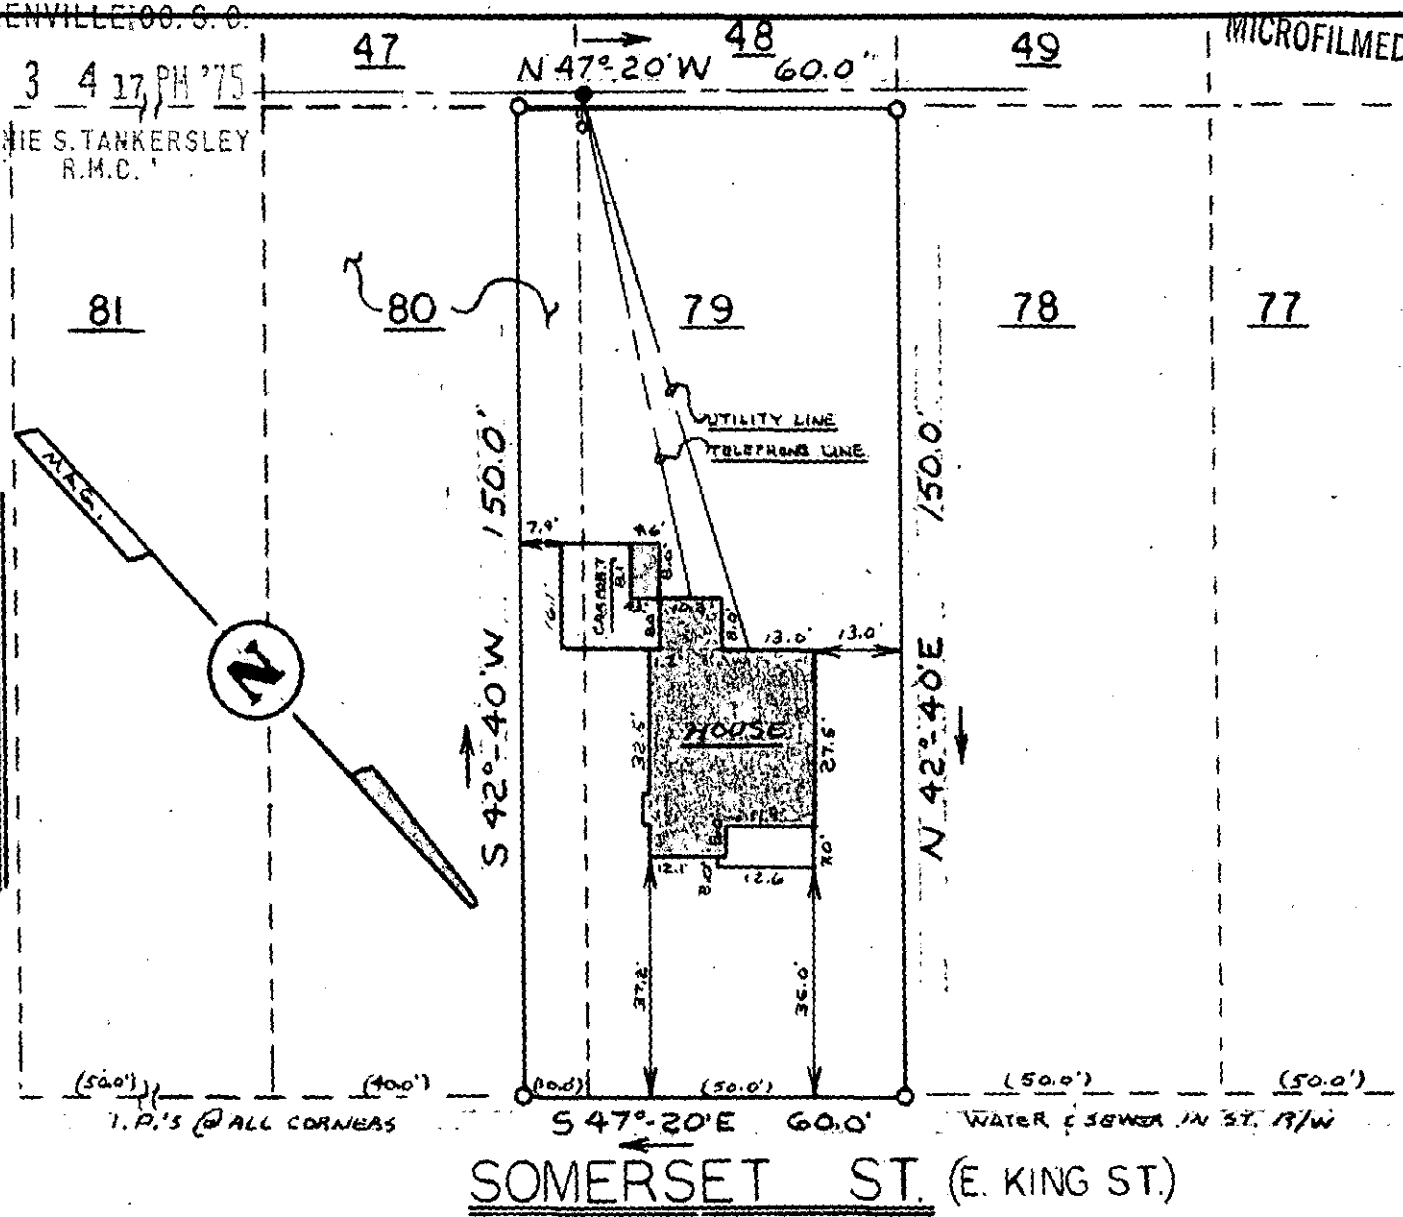


I.P.'S @ ALL CORNERS

WATER & SEWER IN ST. 19/W

This is to certify that on Sept. 25, 1975, I surveyed the property shown on this plat, known as Lot 79 & Part Lot 80, Anderson Street Highlands, filed in the R.M.C. Office of Greenville County in Plat Book J on Page 157, and that the property lines, walls and buildings are as shown hereon; that the building located on said lot does not encroach or project on adjacent streets or property, and that no adjacent walls or buildings encroach or project on said premises, and that no utility lines cross this property except as shown hereon.

James R. Freeland
James R. Freeland RLS 4781

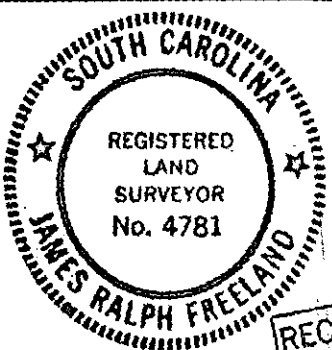

**STATE OF SOUTH CAROLINA
GREENVILLE COUNTY**
ANDERSON STREET HIGHLANDS
LOT 79 PART LOT 80
PROPERTY OF 9035
CHARLES S. COTHRAN

FREELAND & ASSOCIATES
Engineers • Land Surveyors
GREENVILLE, S. C.

RECORDING FEE
PAID 100

SURVEY FL MC
DRAWN FL
CHECK MC
SCALE 1"=30'
DATE 9-25-75
DWO. NO. 75-667

SEAL

5N-58 OCT 3 1975