

- NOTES:**
1. The plans shown on this drawing consists of two bedroom units.
 2. Each unit consists of the space bounded by the undercoated and/or unfinished surfaces of the floors, ceilings, and perimeter or load bearing walls, except with respect to the walls between the adjacent units, the vertical boundary line of each unit shall be the center of the party wall.
 3. All interior and exterior angles are 90 degrees unless otherwise noted.
 4. Unless otherwise noted all areas other than units and limited common elements are to be considered common elements.

LEGEND

— BOUNDARY OF UNIT


ARCHITECTS CERTIFICATION

I, Joe W. Hiller, do hereby certify that this plan fully depicts within reasonable construction tolerances the layout, location, number-letter identifications, and dimensions of the buildings and dwellings contained therein.

DATE: AUG. 20 76

Joe W. Hiller

STATE OF SOUTH CAROLINA
658
REGISTERED ARCHITECT

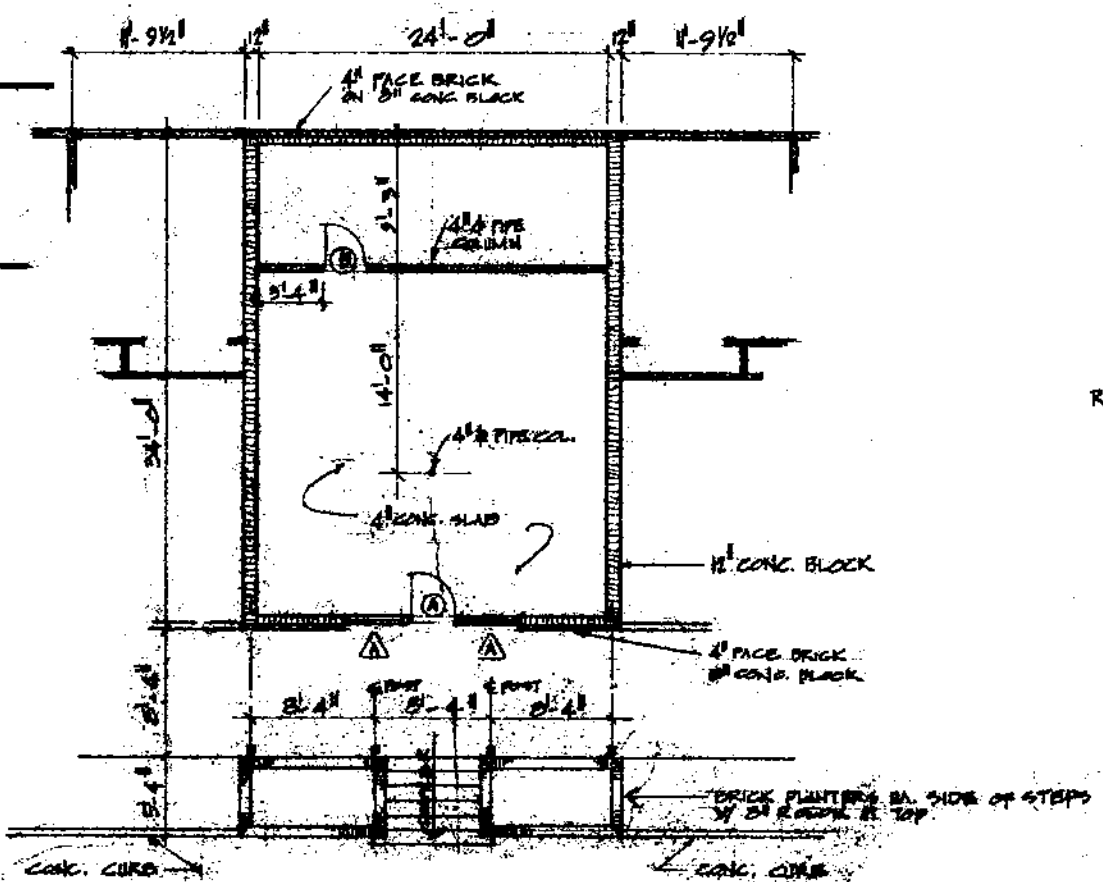

MIDDLETON PLACE
HORIZONTAL PROPERTY REGIME
FLOOR PLANS

EXHIBIT B
SHEET 2 OF 4

AUG 27 1976
#5670
5-R-87B

RECORDING FEE
PAID \$ 3.00