

This is to certify that on September 24, 1976 Enwright Associates, Inc. surveyed the property on this plat, being the same property described in deed of KEL-MAC Properties, A Partnership to C.W.I., A Partnership, dated April 1, 1976 and recorded in the R.M.C. Office in Greenville County in Deed Book Page on September 1976; that said plat is true and correct and that the dimensions of all structures and improvements are as shown on said plat; that the structures and improvements are within the lot lines, and no restrictive building lines have been violated; that there are no easements or encroachments on said property except for water, sewer, power and telephone, other than any recorded easement as shown on said plat; that the rights-of-way of U.S. Highway 276 (Laurens Road) and State Road 107 (Butler Avenue) are as shown on said plat.


William R. Mc Coy  
P.E. & R.L.S. #3551

SUBBANCO PROPERTIES, INC.

C.W.I. A PARTNERSHIP

W.J.W., INC.

MAG ASSOCIATES

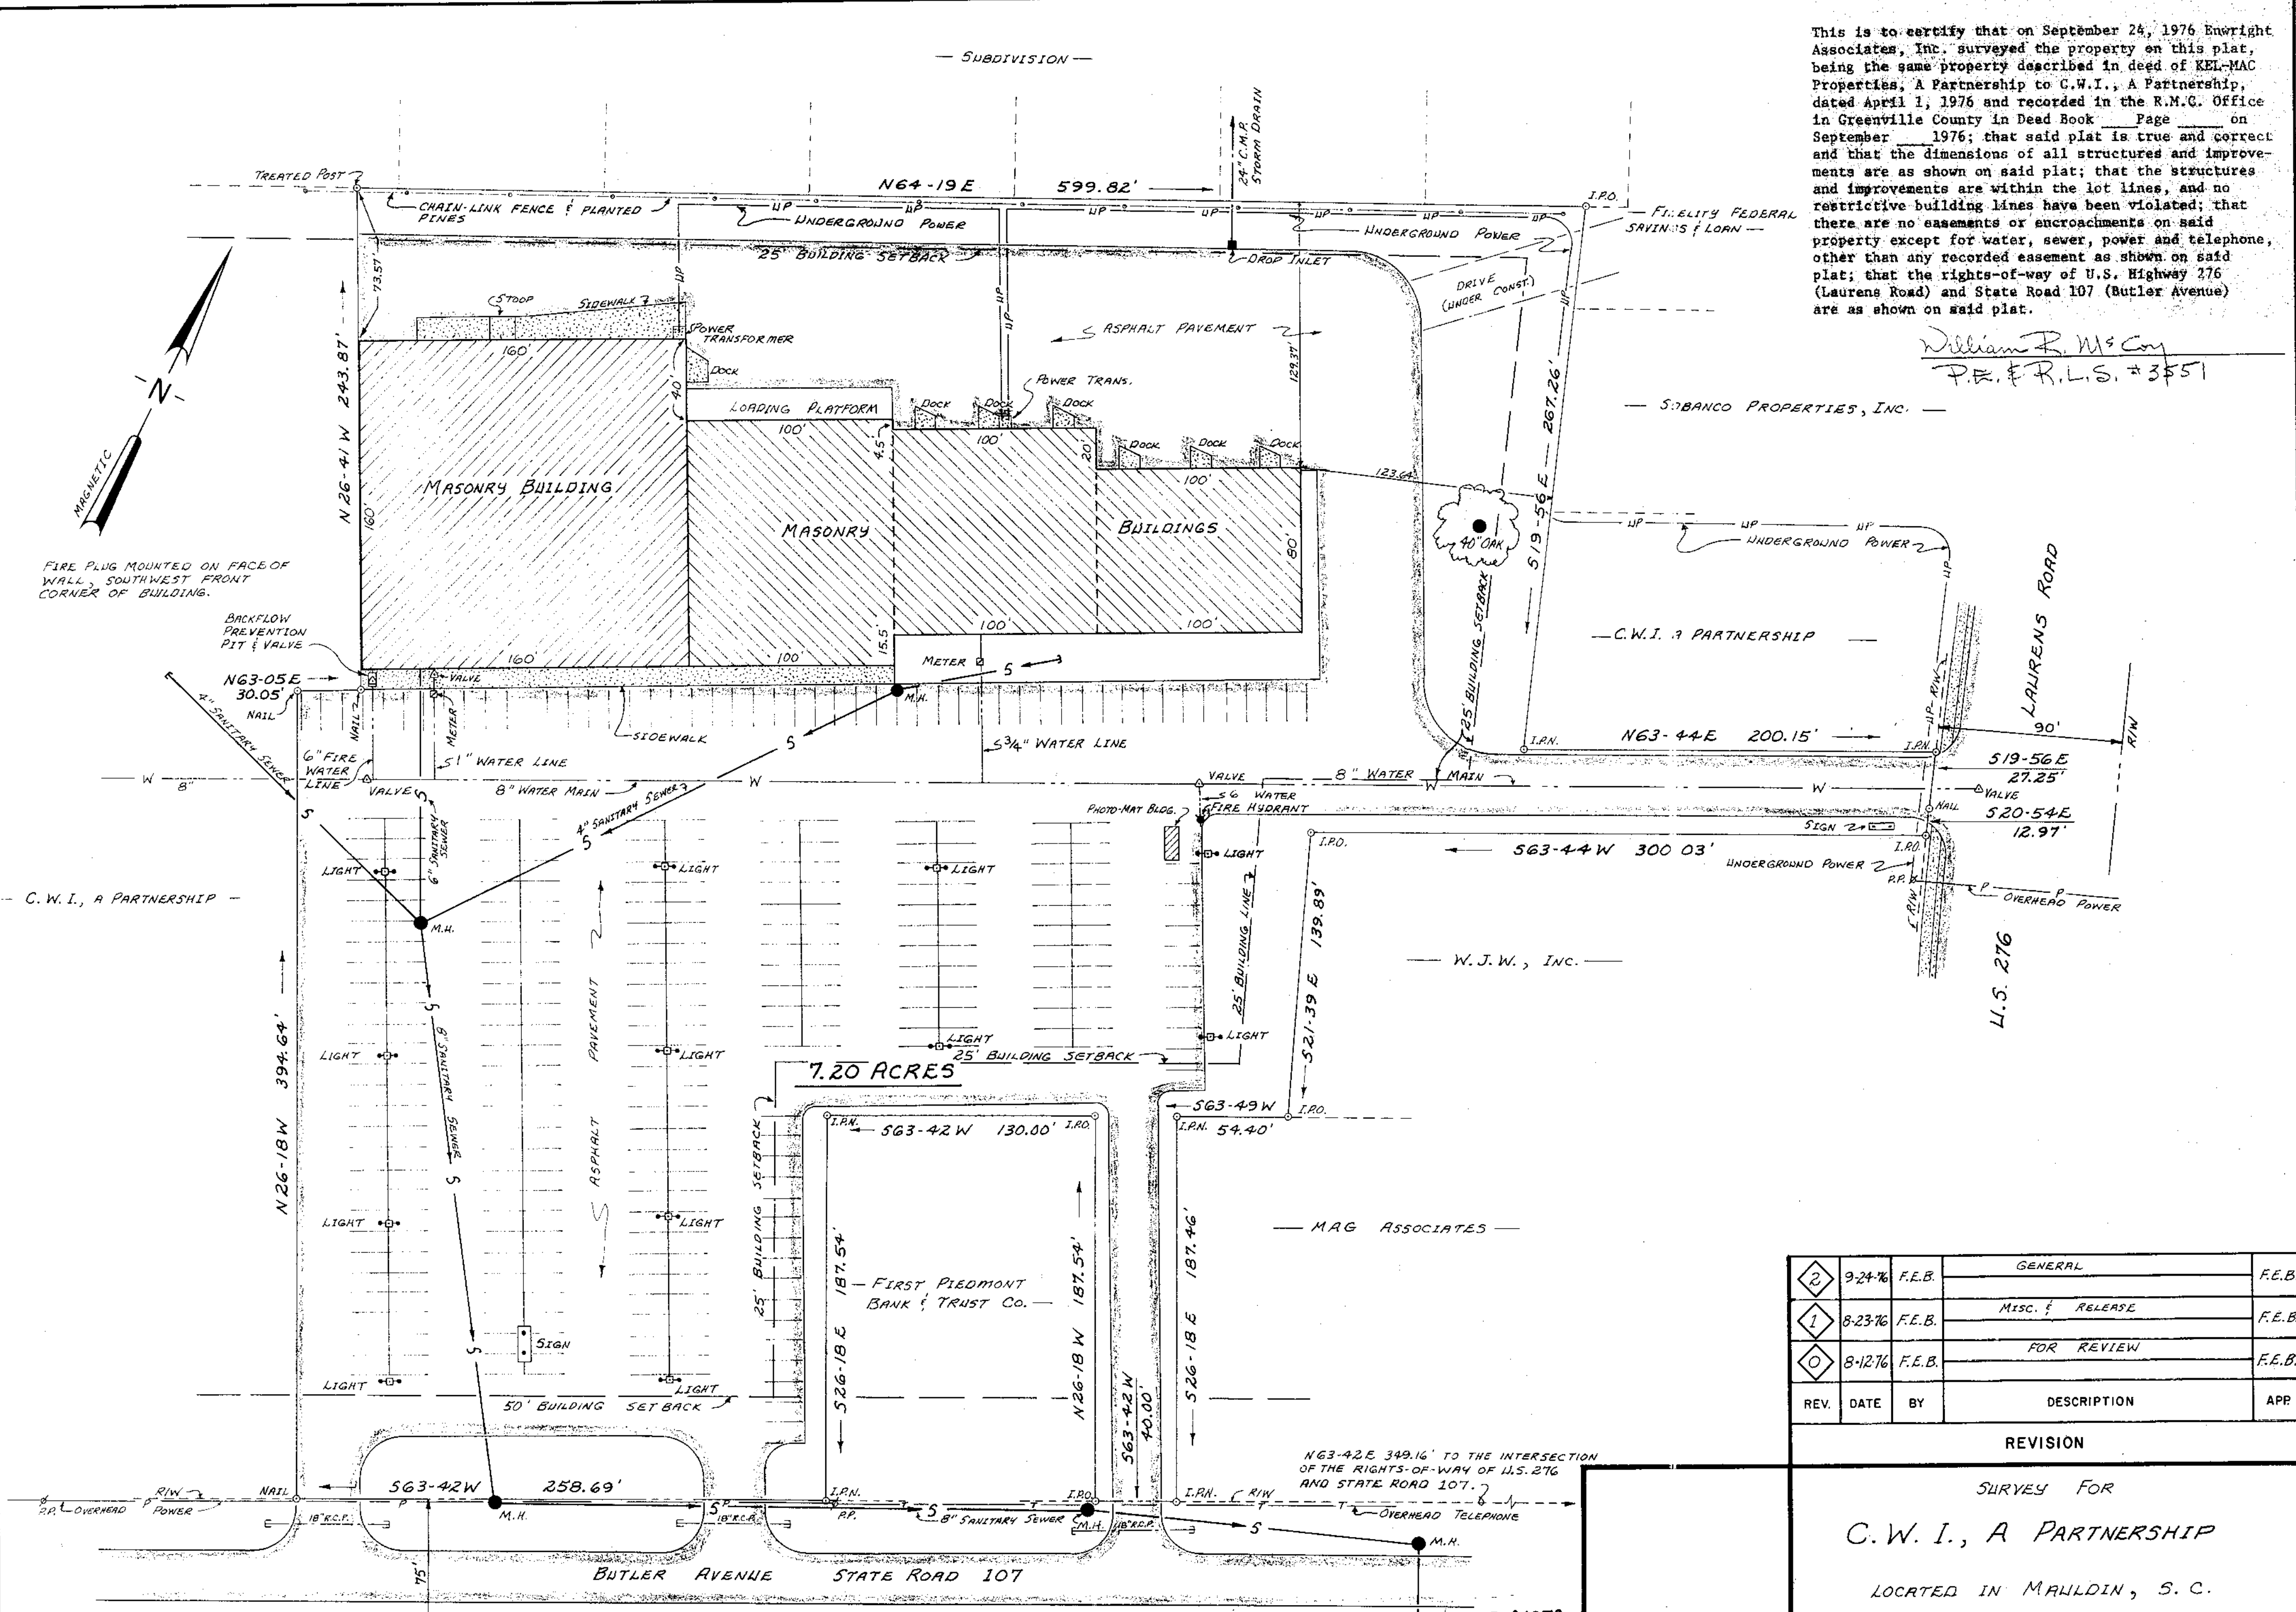

REV.	DATE	BY	DESCRIPTION	APP
2	9-24-76	F.E.B.	GENERAL	F.E.B.
1	8-23-76	F.E.B.	MISC. & RELEASE	F.E.B.
0	8-12-76	F.E.B.	FOR REVIEW	F.E.B.

REVISION

SURVEY FOR  
**C.W.I., A PARTNERSHIP**  
LOCATED IN MAULDIN, S.C.  
GREENVILLE CO., SOUTH CAROLINA

FILED  
GREENVILLE CO. S.C.  
SEP 24 4 36 PM '76  
DONNIE S. PARKER  
R.M.C.

1691 5-R-94 ✓  
RECORDING FEE PAID \$ 3.00  
\$ 41976  
REFERENCE: GREENVILLE CO. TAX MAP M8, BLOCK 1 LOT 15

enwright associates, inc.  
engineers planners surveyors  
GREENVILLE, SOUTH CAROLINA

F.E.B. DRAWN	DESIGN	W.R.M. CHECK	FILE	RETIRED
8-12-76	1"=50' FEET	DATE	SCALE	DWG. NO.
			76517	

