FILED
GREENVILLE CO. S. C.
MAY 6 2 16 PM '76
DONNIE S. TANKERSLEY
R.M.C.

MICROFILMED

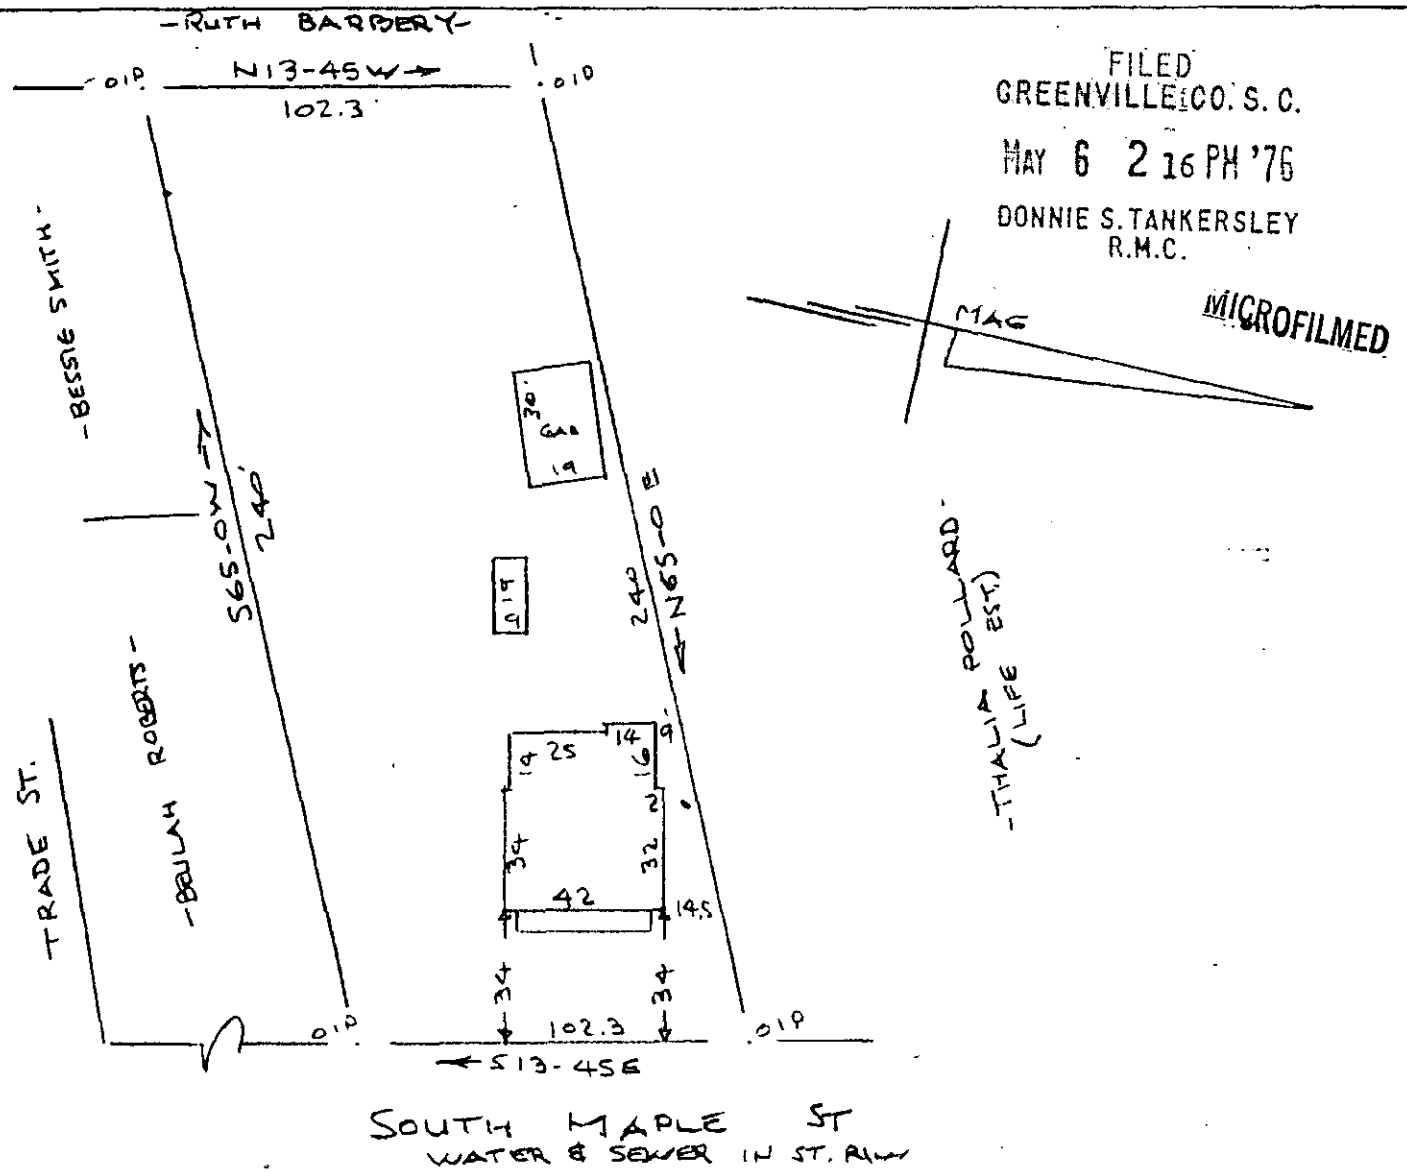

PROPERTY OF
ROBERT G. KNABE & KATHRYN P. KNABE
SIMPSONVILLE, S.C. - GREENVILLE CO.
SCALE: 1"=50' 5 MAY 1976

This is to certify that on the 5th day of May 1976, I surveyed the property shown on this plat, being known as PROPERTY OF ROBERT G. KNABE & KATHRYN P. KNABE and recorded in the RMC Office Greenville County, S. C., in Plat Book at Page ; and that the property lines, walls and buildings are as shown hereon, and that the walls and buildings located on said lot do not encroach or project on adjacent street or property, and that no adjacent walls or buildings encroach or project on said premises, and no power lines cross this property except as shown hereon.

MAY 6 1976

R. B. Bruce

R. B. Bruce, RLS #1952

SOUTH CAROLINA REGISTERED LAND SURVEYOR R. B. BRUCE 1952

55-61 28604

REC. RING FEE
PAID $ 1.00

CAROLINA SURVEYING CO.
112 Manly St.
Greenville, S. C.

170/64