


MICROFILMED

MOORE

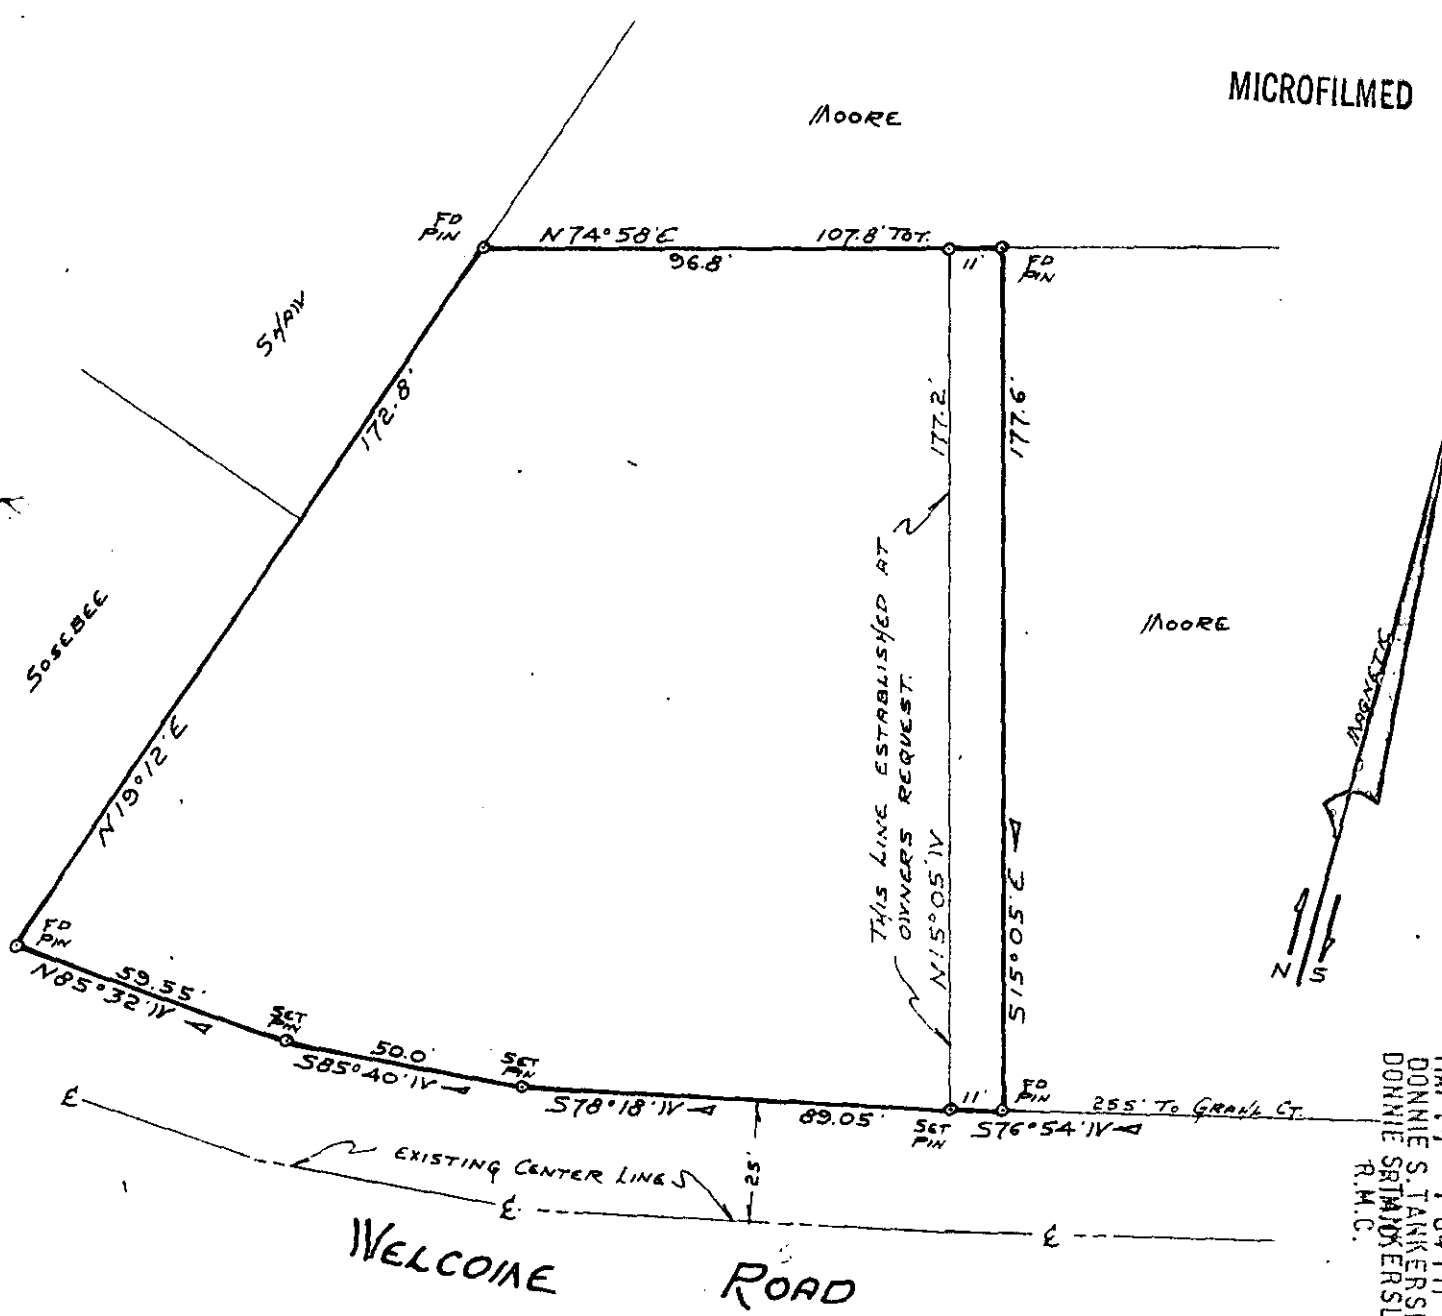

GREENVILLE CO. S.C.
 MAY 11 4 04 PM '76
 MAY 11 4 04 PM '76
 DONNIE S. TANKERSLEY
 DONNIE S. TANKERSLEY
 R.M.C.

PROPERTY OF
 HAROLD L. MOORE
 AND

MARY WHITIRE MOORE
 NEAR GREENVILLE, SO. CAROLINA
 SCALE 1" = 40' APRIL 26, 1976

RECORDING FEE
 PAID \$ 1.00

REFERENCE
 PLAT BOOK CC
 PAGE 131
 PLAT BOOK XX
 PAGE 73
 PLAT BOOK DDD
 PAGE 44

29505

✓ 5-S-73

SOUTH CAROLINA
 MAY 11 1976
 BY CAMPBELL & CLARKSON
 SURVEYORS, INC.
 S.C.R.L.S. No. 2980