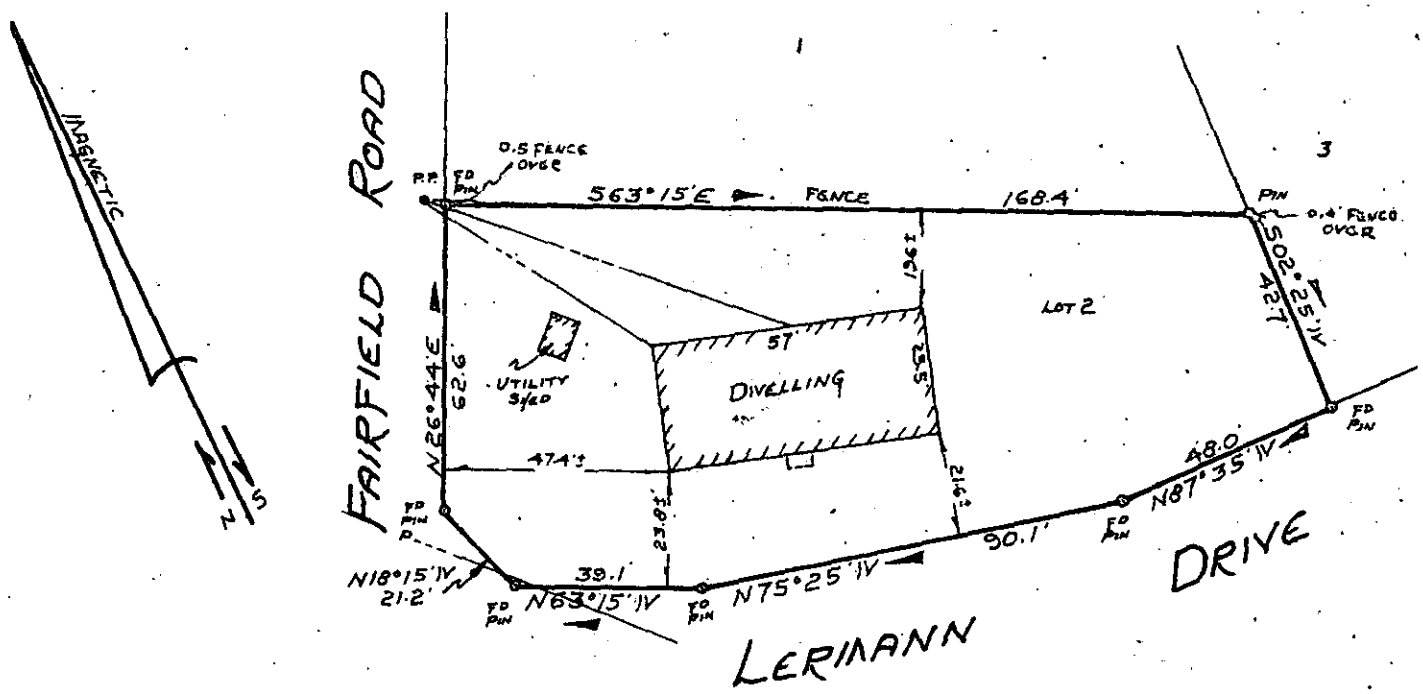

PROPERTY OF
WILLIAM DAVID LOGAN
AND
JANIE T. LOGAN
NEAR GREENVILLE, SOUTH CAROLINA
SCALE 1" = 40' APRIL 25, 1977

FILED
GREENVILLE CO. S.C.
APR 27 12 41 PM '77
DONNIE S. TANKERSLEY
R.M.C.

This is to certify that on April 25, 1977, I surveyed the property shown on this plat, known as Lot No. 2 of Section II of Fairfield Acres as shown on a plat recorded in the RMC Office for Greenville Co. in Plat Book FF at page 459, and that the property lines, walls and building are as shown hereon, and that the building located on said lot does not project nor encroach on adjacent streets or property, and that no adjacent walls or buildings project nor encroach on said lot, and that no utility lines cross this lot except as may be shown hereon.

NOTE: This property is not located within a flood hazard area.

Survey by Campbell & Clarkson Surveyors, Inc.

SOUTH CAROLINA REGISTERED PROFESSIONAL SURVEYOR

S. C. R. L. S. No. 678

6-D-1

28995

1 0 0 8 APR 27 C 1.00 A4

MICROFILMED

BK D' PG 24