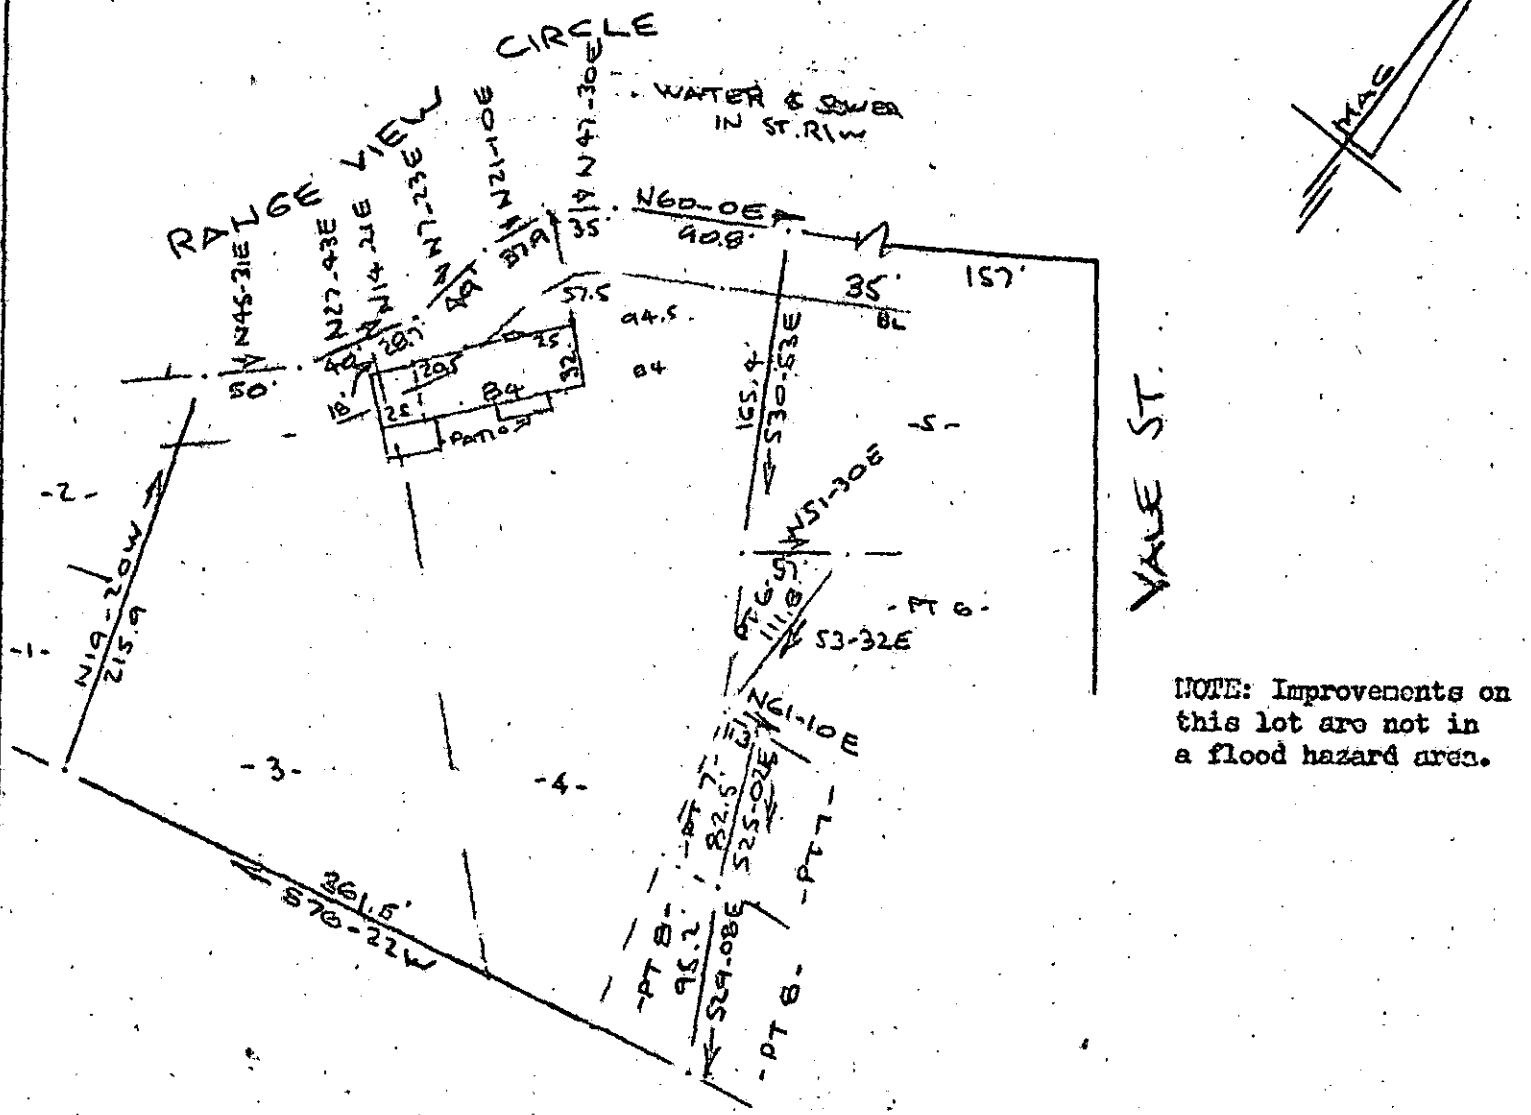

NOTE: Improvements on this lot are not in a flood hazard area.

PROPERTY OF
M. E. DURHAM
NEAR GREENVILLE, S. C.
SCALE: 1"=100' 3 MAY 1977

This is to certify that on the 3rd day of May, 1977, I surveyed the property shown on this plat, being known as lots 3 and 4 and part of lots 6, 7 & 8 on plat of WHITE HORSE HEIGHTS and recorded in the RMC Office Greenville County, S. C., in Plat Book " BB " at Page 135; and that the property lines, walls and buildings are as shown hereon, and that the walls and buildings located on said lot do not encroach or project on adjacent street or property, and that no adjacent walls or buildings encroach or project on said premises, and no power lines cross this property except as shown hereon.

6-D-31

R. B. Bruce

R. B. Bruce, RLS #1952

CAROLINA SURVEYING CO.
112 Manly St.
Greenville, S. C.

30193

MICROFILMED
MAY 6 1977

FILED
GREENVILLE CO. S. C.
MAY 6 8 37 AM '77
DONNIE S. TANKERSLEY
R.M.C.

3362 PAGE 6M

BK C.O.T. 46

700126