
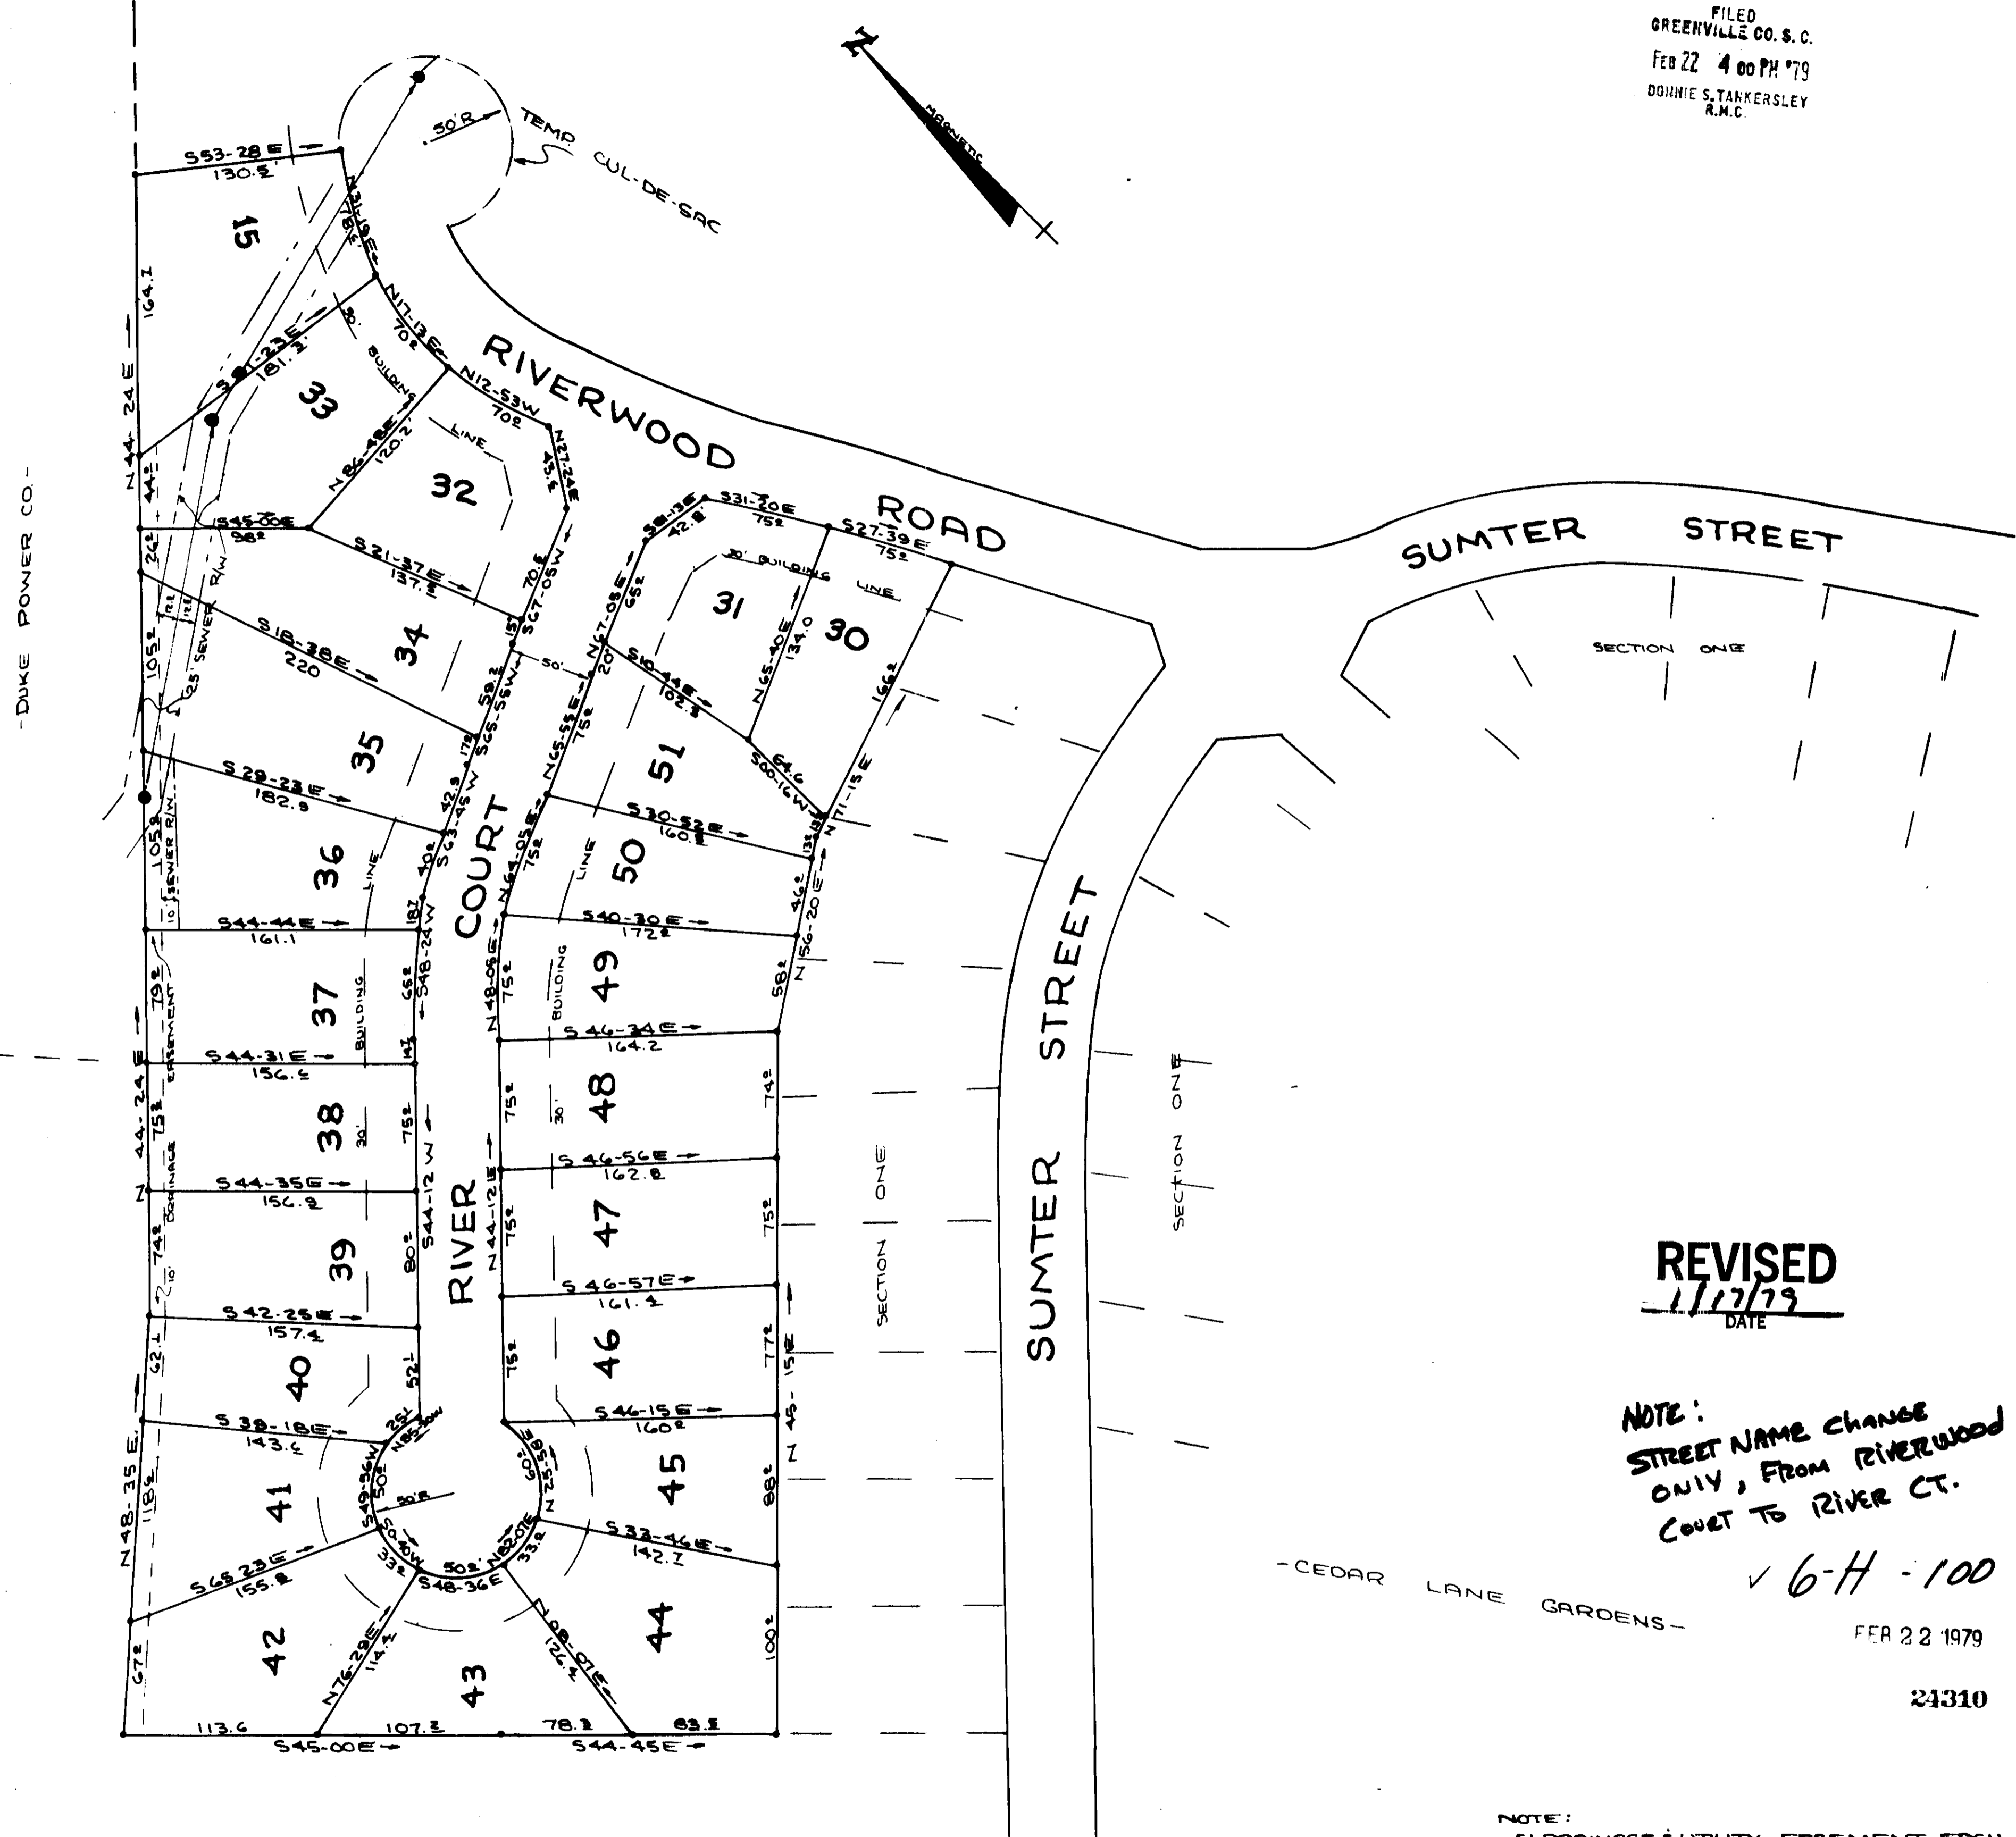


FILED
GREENVILLE CO. S. C.
FEB 22 4 00 PM '79
DONNIE S. TANKERSLEY
R.M.C.

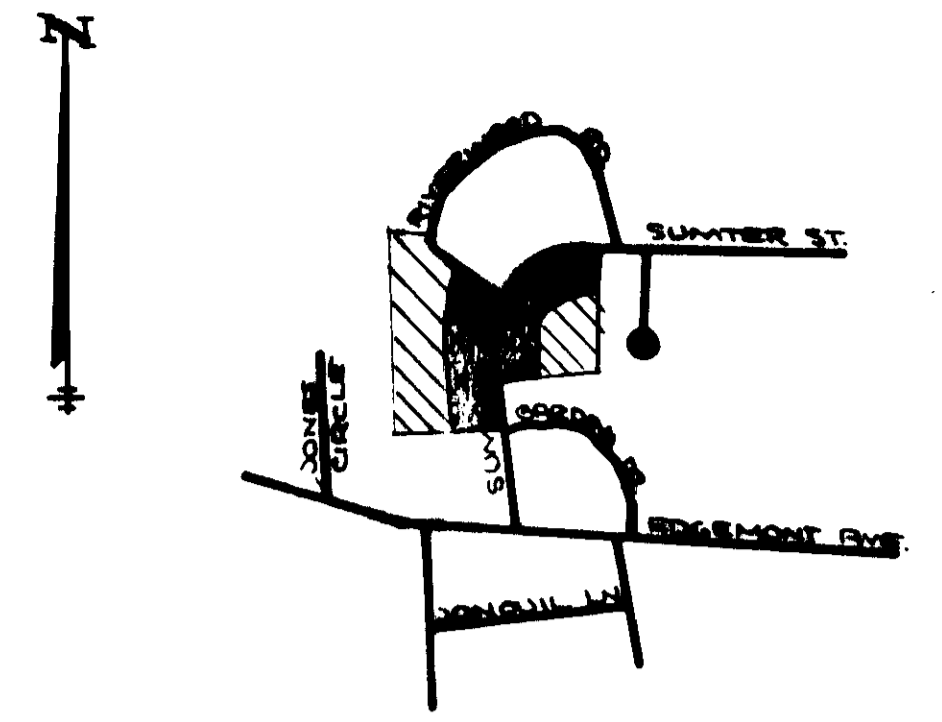

FINAL PLAT

CERTIFICATE OF OWNERSHIP AND DEDICATION

"The undersigned hereby acknowledge that I am (we are) the owner(s) of the property shown and described hereon and that I (we) hereby adopt this plan of subdivision with my (our) free consent and that I (we) establish the minimum building restriction lines, and hereby dedicate to public use as roads, streets, and easements, forever all areas so shown or indicated on said plat.

2/16/79 Signed Gally P. Hall
 2/16/79 Signed J. H. Philpot
 2/16/79 Signed W. R. Williams, Jr.
 2/16/79 Signed L. Henry Philpot

CERTIFICATE OF ACCURACY

"I, W. R. Williams, Jr., certify that this plat was drawn by me (shown under my supervision) (an actual survey made under my supervision) from (an actual survey made by me) (a deed description recorded in Book _____ Page _____ Book _____ Page _____ etc.) (other); that the error of closure as calculated by latitudes and departures is _____, that the boundaries not surveyed are shown as broken lines plotted from information found in Book _____ Page _____ that this plat was prepared in accordance with the Greenville County Subdivision Regulations as adopted.

OCT 4 1978 DATE
W. R. Williams, Jr.
 LICENSED ENGINEER OR REGISTERED SURVEYOR
 S. C. Registration No. 3979

CERTIFICATE OF APPROVAL FOR RECORDING

"I hereby certify that the subdivision plat shown hereon has been found to comply with the Subdivision Regulations for Greenville County, with the exception of such variances, if any, as are noted in the minutes of the Greenville County Planning Commission of Greenville County, South Carolina, and that it has been approved for recording in the office of the County Register of Deeds Conveyances."

2/22/79 DATE
Royce J. Carter
 DIRECTOR OF PLANNING
 GREENVILLE COUNTY PLANNING COMMISSION

REVISED
 1/17/79
 DATE

NOTE:
 STREET NAME CHANGE
 ONLY, FROM RIVERWOOD
 COURT TO RIVER CT.

✓ 6-H-100

- CEDAR LANE GARDENS -

FEB 22 1979

24310

- HAYNSWORTH HGTS -

REVISED
 1/17/79
 DATE

Plat Filed This 22 day of Feb. 1979
 And Recorded in Vol. 6-H Page 100 at 4:00 P.M.
Donnie S. Tankersley
 Register Meigs Conveyance Greenville County, S. C.

NOTE:
 5' DRAINAGE & UTILITY EASEMENT EACH
 SIDE OF ALL SIDE & REAR LOT LINES.
 IRON PINS AT ALL CORNERS

FILE NUMBER
78-163
 SECTION THREE
RIVERWOODS

I. H. Philpot W. R. Williams, Jr.
 O.E. HUFF SURVEYOR
 OWNER SURVEYOR

NO. OF ACRES: 7.2 MILES 0.1
 NO. OF LOTS: 23 DATE: OCTOBER 1978

