
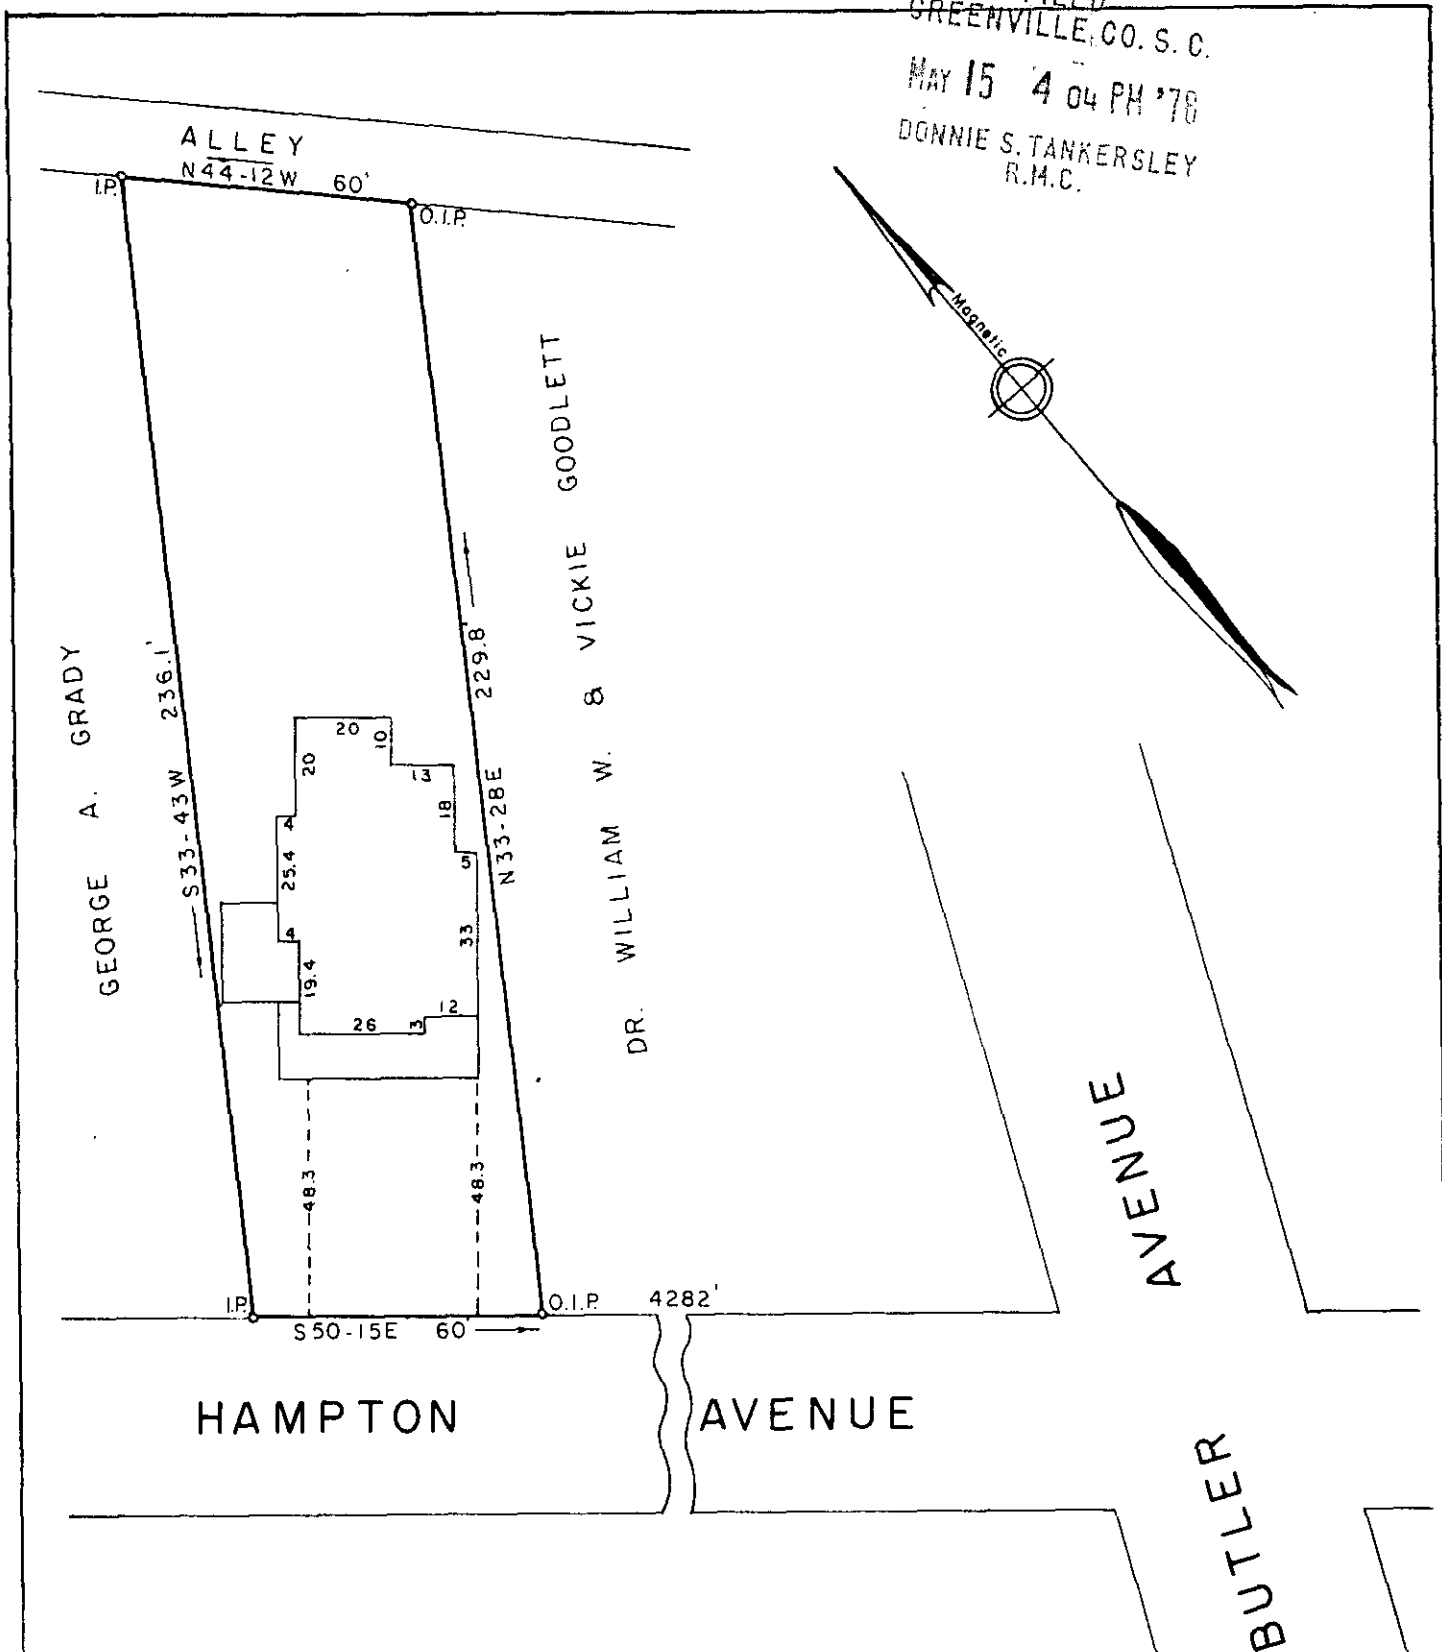


FILED
GREENVILLE, CO. S. C.

MAY 15 4 04 PM '78

DONNIE S. TANKERSLEY
R.M.C.

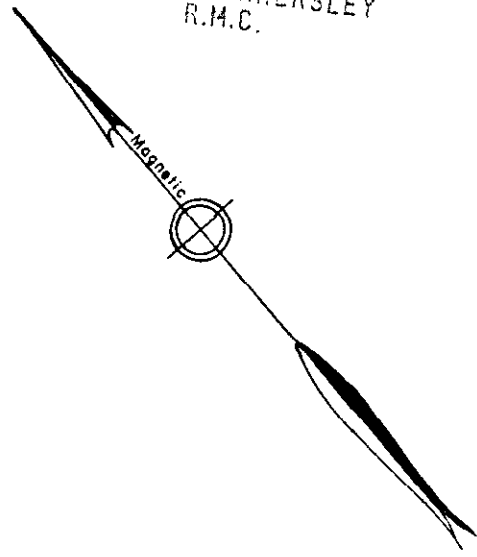

HAMPTON

AVENUE

AVENUE

BUTLER

PROPERTY OF

NIS CHRISTIAN NIELSEN III

KATRINA B. NIELSEN

JAMES GREGORY NIELSEN

GREENVILLE CO., S.C.

Scale 1" = 40' May, 1978

This is to certify that on the 9th day of May, 1978, We surveyed the property shown on this plat; and that the property lines, walls and buildings are as shown hereon; that the buildings located on said lot do not encroach or project on adjacent streets or property; and that no adjacent buildings or walls encroach or project on said premises; and from information from Greenville County, this structure is not in a designated flood area.

William B. Fant
Dalton & Neves Co., Engineers

MAY 15 1978

MICROFILMED

16-0-17

33991

F.B. 430
S.C. Reg. No. 6266

Bik. Bk. 18-1-22

GETO 1 MAY 15 78 1418
1:0001

