"THIS PROPERTY IS NOT LOCATED IN A FLOOD PLAIN." J. E. Montgomery

MICROFILMED

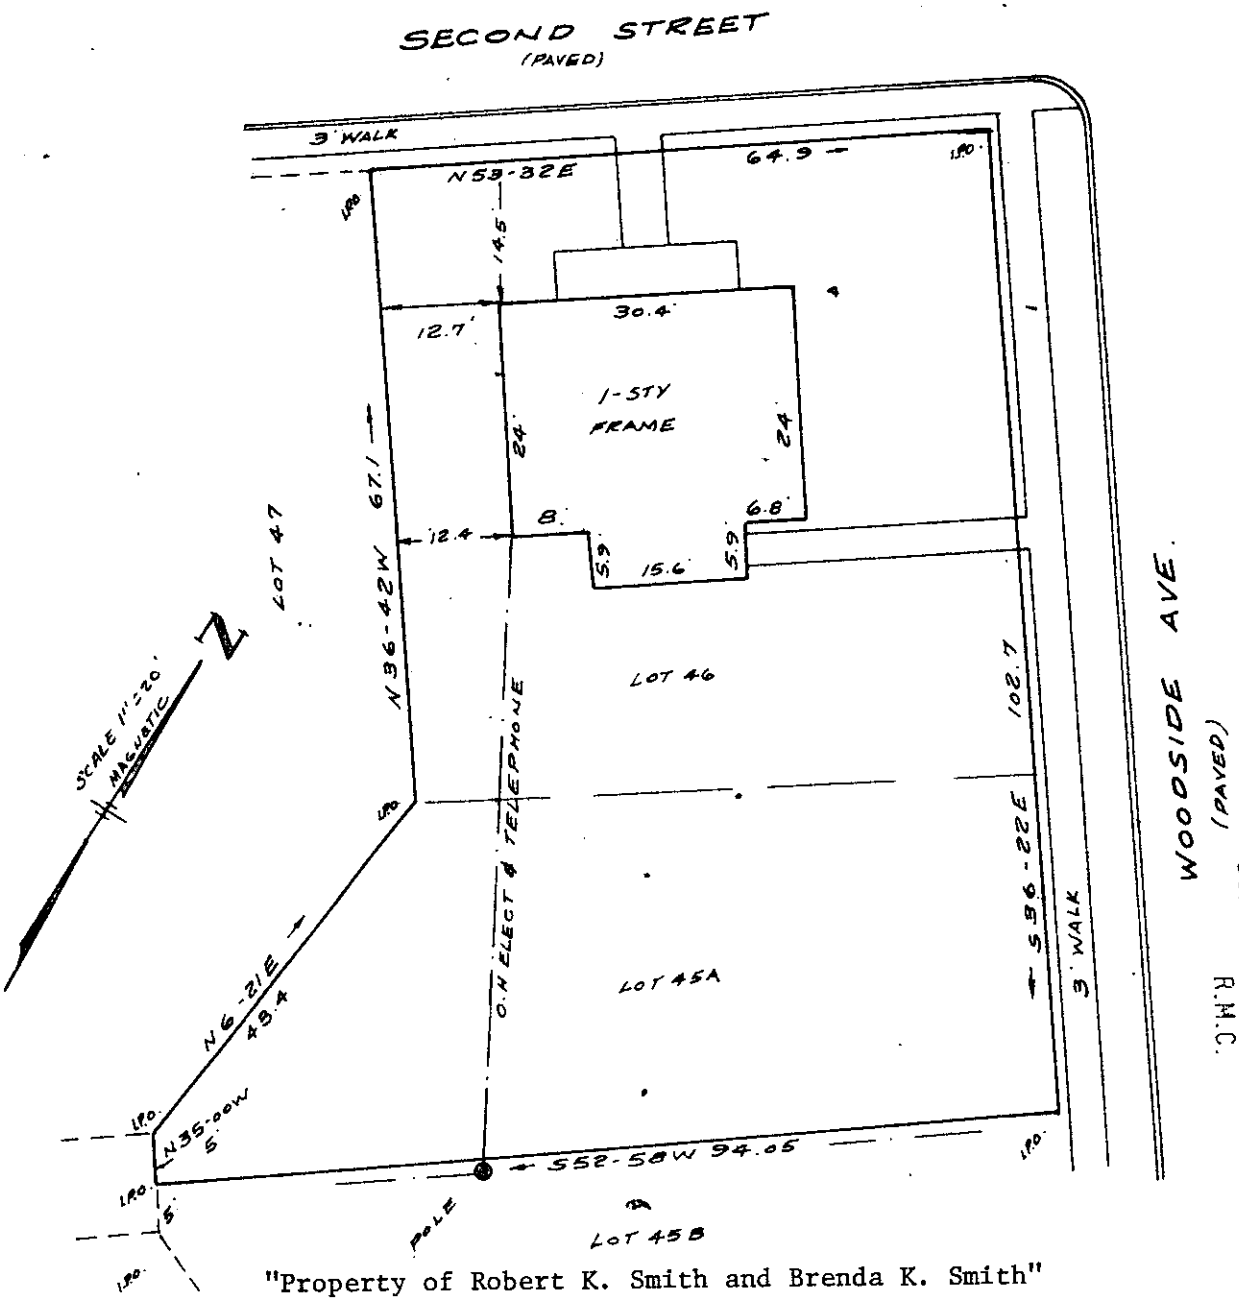

"Property of Robert K. Smith and Brenda K. Smith"

FILED
GREENVILLE CO. S. C.
JUN 14 10 05 AM '78
DONNIE S. TANKERSLEY
R.M.C.

THIS IS TO CERTIFY THAT ON THE 7th DAY OF JUNE, 1978, I SURVEYED THE PROPERTY SHOWN ON THIS PLAT, BEING KNOWN AS LOT 46 & PART 45A ON PLAT OF WOODSIDE MILLS, AND RECORDED IN THE R. M. C. OFFICE GREENVILLE COUNTY, S. C. IN PLAT BOOK Z AT PAGE 64; AND THAT THE PROPERTY LINES, WALLS, AND BUILDINGS ARE SHOWN HEREON, AND THAT THE WALLS AND BUILDINGS LOCATED ON SAID LOT DO NOT ENCROACH OR PROJECT ON ADJACENT STREETS OR PROPERTY, AND THAT NO ADJACENT WALLS OR BUILDINGS ENCROACH OR PROJECT ON SAID PREMISES, AND NO POWER LINES CROSS THIS PROPERTY EXCEPT AS SHOWN HEREON.

SOUTH CAROLINA REGISTERED LAND SURVEYOR

J. E. MONTGOMERY, III.
R. L. S. No. 4552
Simpsonville, S. C.

✓6-Q-85

37548

GCTO ----3 JN14 78 1107

1.00CI