


MICROFILMED

- JOHN & NELLIE GILLESPIE -

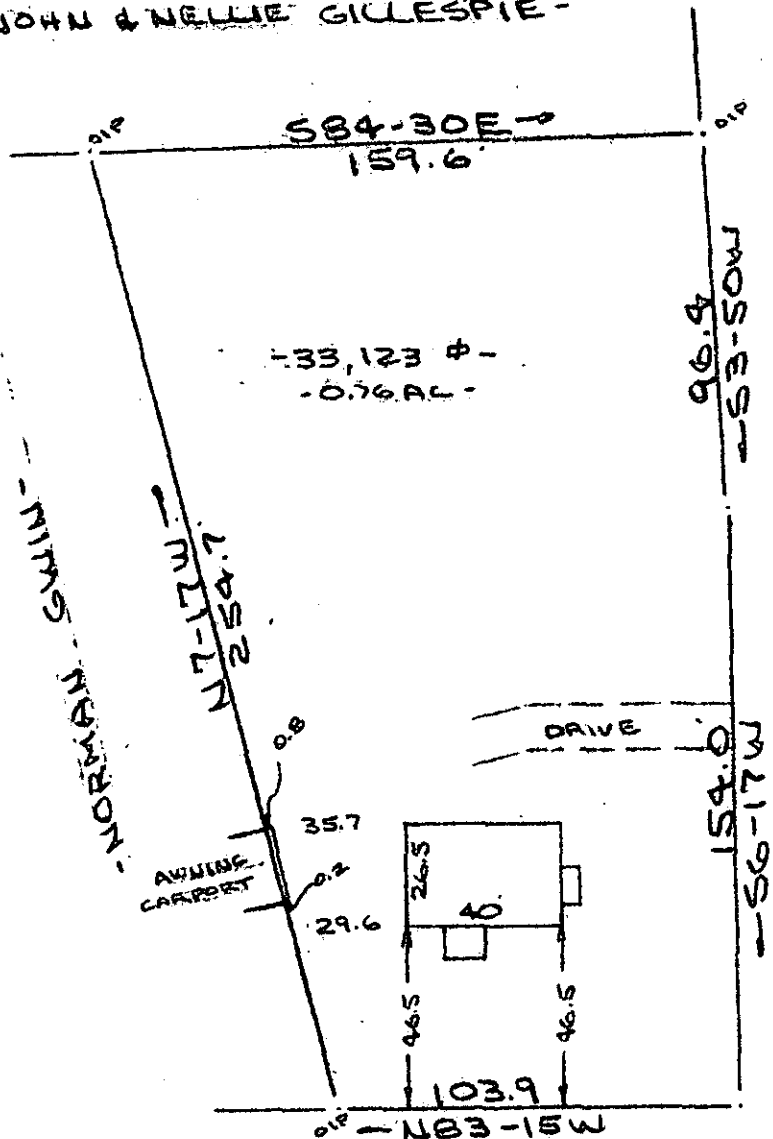

FRANKLIN ROAD

CAMBRIDGE ROAD

SURVEY FOR
 JOHN H. GILLESPIE
 NEAR GREENVILLE, S.C.
 SCALE: 1"=50 6 JUNE 1978


FILED
 GREENVILLE, CO. S.C.
 JUN 15 12 52 PM '78
 DONNIE S. TANKERSLEY
 R.M.C.

GCTO -----3 JN1578 4201

16-Q-91

37710

CAROLINA SURVEYING
 112 MANLY ST.
 GREENVILLE, S.C.

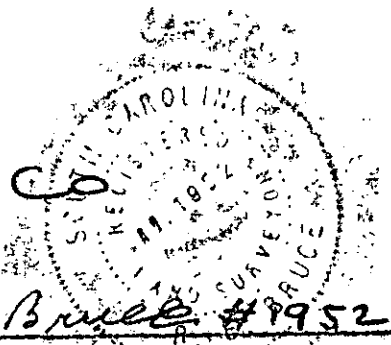

1.00CI