MICROFILMED

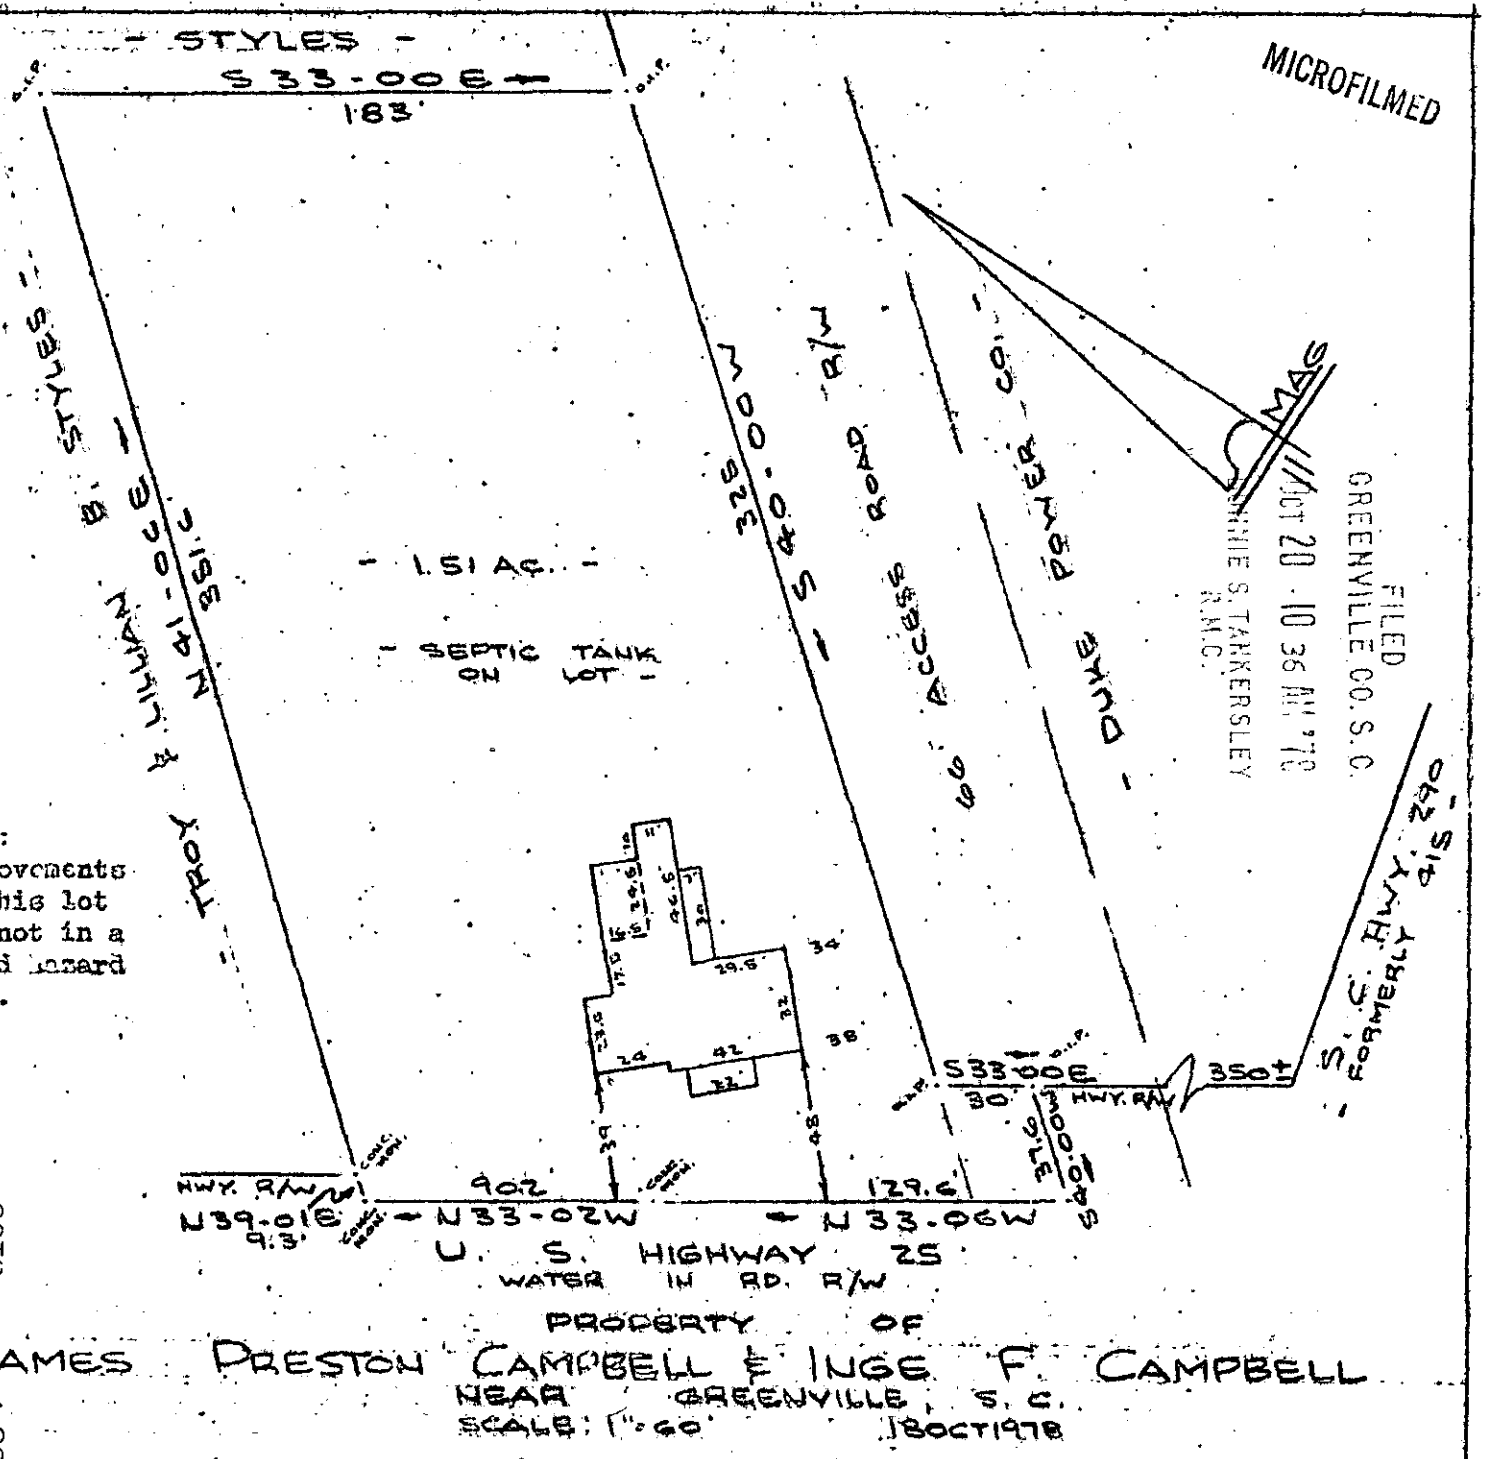

FILED
GREENVILLE CO. S. C.
OCT 20 10 36 AM '78
ANNIE S. TANKERSLEY
R.M.C.

NOTE:
Improvements on this lot are not in a flood hazard area.

GCTC
1 OC20 78
1304

This is to certify that on the 18th day of October, 1978, I surveyed the property shown on this plat, being known as 1.51 acres on plat of PROPERTY OF JAMES PRESTON CAMPBELL AND INGE F. CAMPBELL and recorded in the RMC Office Greenville County, S. C., in Plat Book at Page ; and that the property lines, walls and buildings are as shown hereon, and that the walls and buildings located on said lot do not encroach or project on adjacent street or property, and that no adjacent walls or buildings encroach or project on said premises, and no power lines cross this property except as shown hereon.

✓ 6W-51

R. D. Bruce, RLS #1952

1.00CI

12530

CAROLINA SURVEYING CO.
112 Manly St.
Greenville, S. C.

208/43

523.2-1-25