


MICROFILMED

112 DOUGLASS TAYLOR JR. REC. GREENVILLE OCT 28 1978

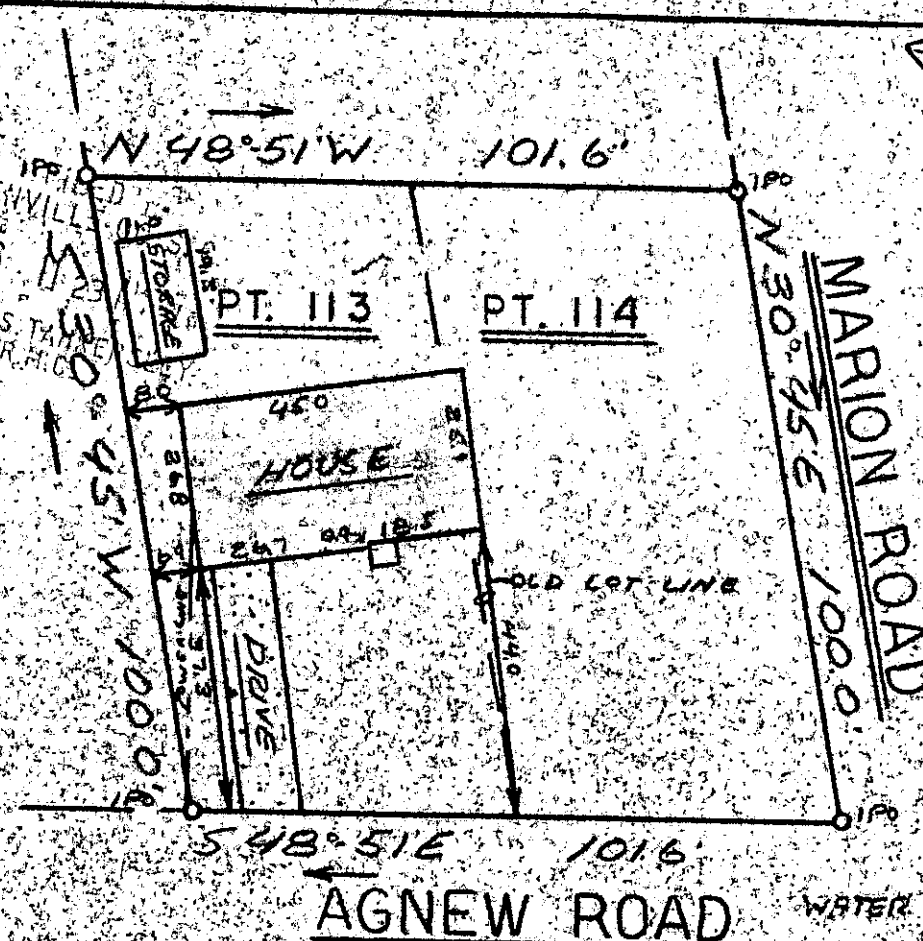

AGNEW ROAD

WATER & SEWER IN ST. RAW

This is to certify that on October 24, 1978, I surveyed the property shown on this plat, known as Part Lots 113 and 114 on Plat of Parker Heights, recorded in the REC Office of Greenville County in Flat 1 Book P on Page 43B, and that the property lines, walls and buildings are as shown hereon; that the building located on said lot does not encroach or project on adjacent streets or property, and that no adjacent walls or buildings encroach or project on said premises, and that no utility lines cross this property except as shown hereon.

16-W-60

James R. Freeland
 James R. Freeland RLS & PE 4781
 13929

This property is not located in a designated flood hazard area.



STATE OF SOUTH CAROLINA
GREENVILLE COUNTY
PARKER HEIGHTS
PART LOTS 113 & 114
PROPERTY OF
OTIS ANDREW HALLOWAY

FREELAND & ASSOCIATES
 Engineers • Land Surveyors
 GREENVILLE, S. C.

SURVEY *RP*
 DRAWN *RF*
 CHECK *RF*
 SCALE *1" = 30'*
 DATE *10-25-78*
 DWG. NO. *78-2513*