

MICROFILMED


J. & V. SAMMONS

15

FILED  
GREENVILLE, CO. S. C.

OCT 26 10 30 AM '78

DONNIE S. TANKERSLEY  
R.M.C.

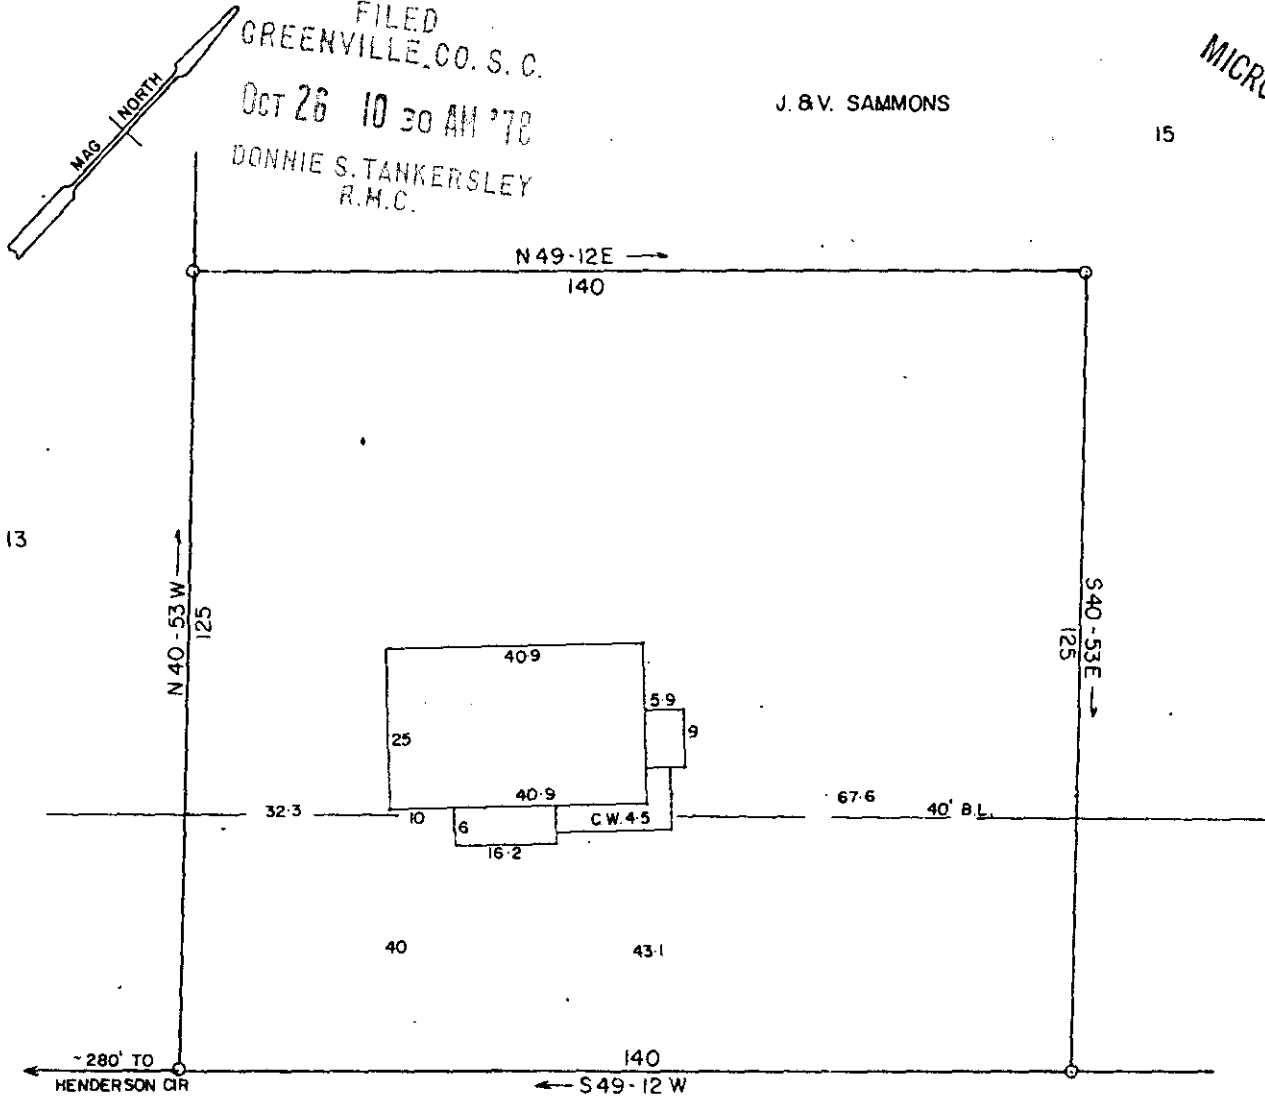

LONGVIEW

TERRACE

PROPERTY OF

HENRY SAMMONS

&

MARY F. SAMMONS



GREENVILLE COUNTY, S. C.

SCALE 1"=30' SEPT. 12-78

13028

OCT 26 1978

*✓ 6W-65*

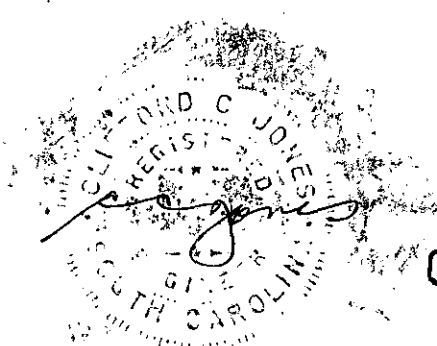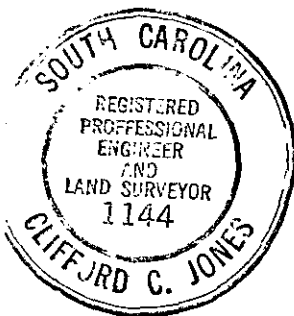

GCTO --- 10C26 78 108

1.00C1