




GREENVILLE TOWNSHIP
GREENVILLE CO.
SAN SOULI AREA

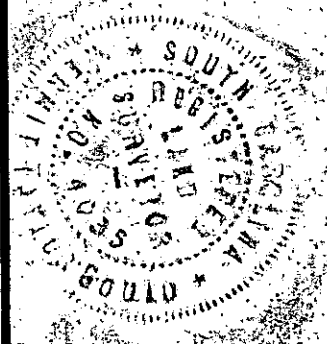

REF. DEED BK 920 PG 38
BK 167-6-1


13878

PROPERTY IS NOT IN A FLOOD PLAIN.
NO ENCROACHMENT EXCEPT AS SHOWN.
ABOVE PROPERTY RESURVEYED AND
IS AS SHOWN

Robert J. Gould
S.C. REG. NO 4035

16W-89

LOT 29

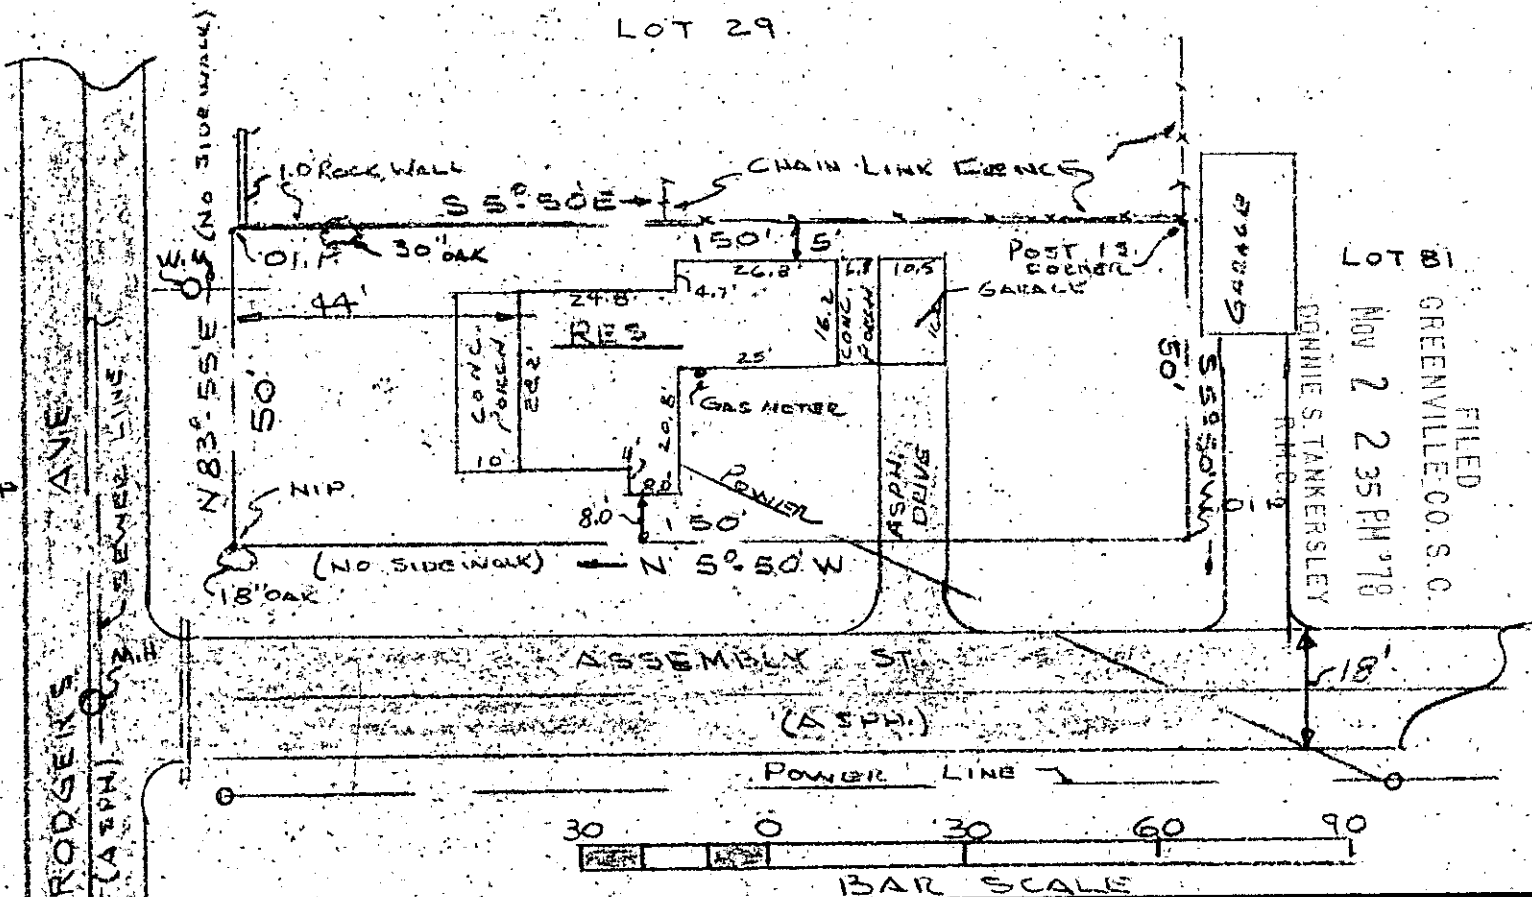

FILED
GREENVILLE CO. S.C.
NOV 2 2 35 PM '79
DONNIE S. TANKERSLEY

PROPERTY OF JOHN EGAN		
SCALE: 1" = 30'	APPROVED BY:	DRAWN BY: K.T.G.
DATE: 10-27-78	REVISED:	
GOLLIG & ASSOC. SURVEYORS S.C.		
LOT # 28 601000-203-NOR 2784125		DRAWING NUMBER 1.00CI

MICROFILMED