FILED
GREENVILLE CO. S. C.
MAY 14 3 35 PM '79
DONNIE S. TANKERSLEY
R.M.C.

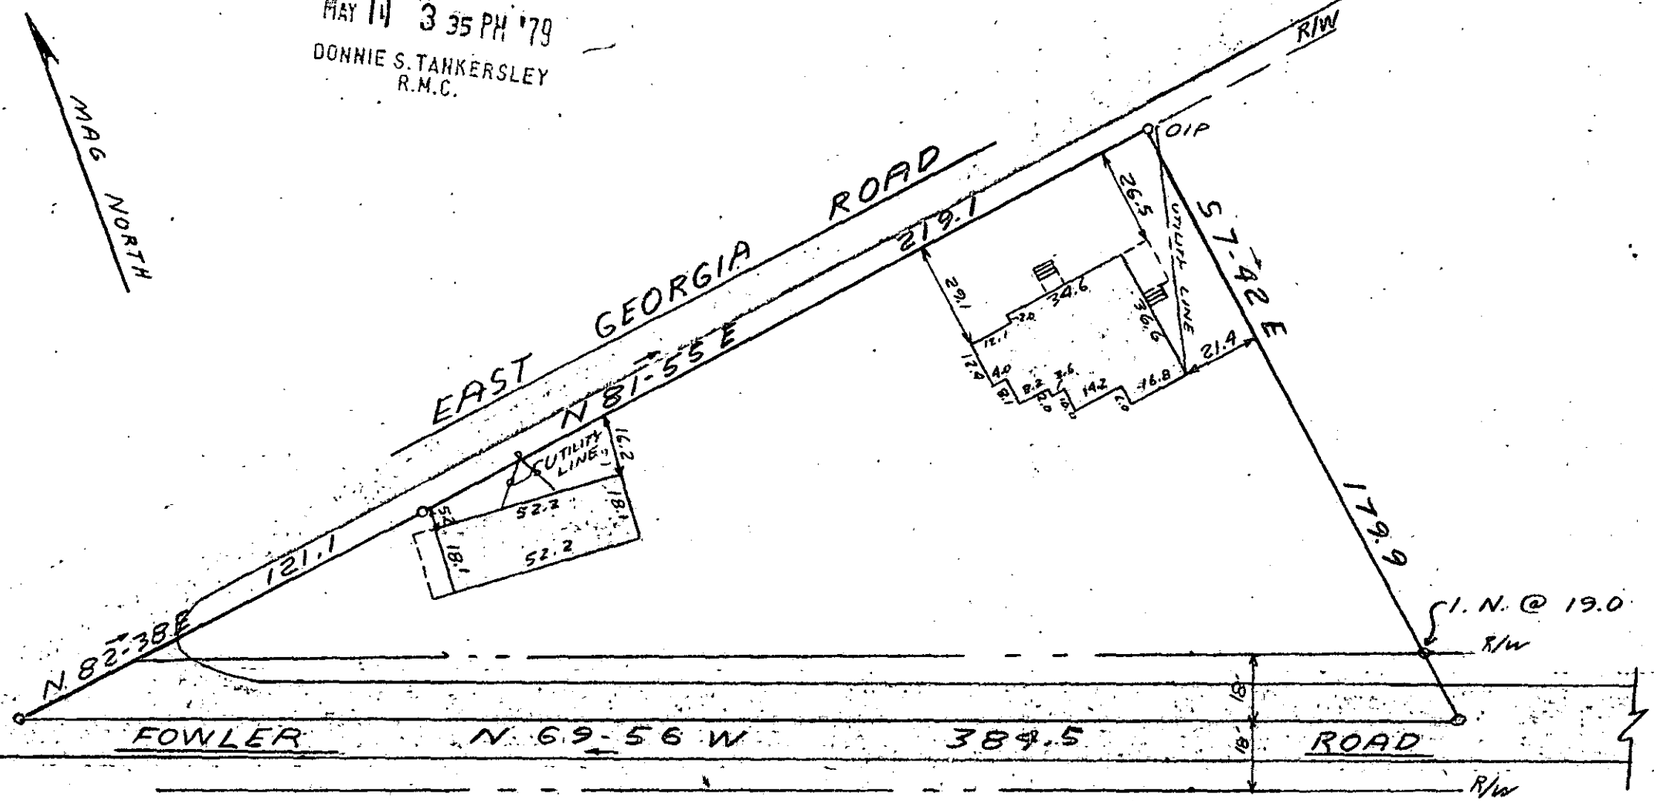

This is to certify that on March 15, 1979, I surveyed the property shown on this plat known as Property of J.L. Fowler and K.L. Fowler recorded in the RMC Office of Greenville County in Deed Book 923 on Page 101, and that the property lines, walls, and buildings are as shown hereon; that the building located on said lot does not encroach or project on adjacent streets or property, and that no adjacent walls or buildings encroach or project on said premises, and that no utility lines cross this property except as shown hereon. This property is not located in a designated flood hazard area

James R. Freeland RLS & PE 4781

33227 17-A-67

MAY 14 1979

SOUTH CAROLINA REGISTERED LAND SURVEYOR NO. 4781 JAMES RALPH FREELAND

SEAL

STATE OF SOUTH CAROLINA
GREENVILLE COUNTY

PROPERTY OF

GEORGE O'SHIELDS BUILDERS

FREELAND & ASSOCIATES
Engineers • Land Surveyors
GREENVILLE, S. C.

SURVEY	DG
DRAWN	JRF
CHECK	JRF
SCALE	1" = 40'
DATE	3-15-79
DWG. NO.	79-3006

BLK. BK. 317-1-15

CCTO 2 MY14'79 1087 2.00CI

MICROFILMED