MICROFILMED

NOTE: REVISION OF LOT 1
LEE EAST SUBDIVISION

FILED
GREENVILLE CO. S. C.
MAR 6 3 55 PM '79
DONNIE S. TANKERSLEY
R.M.C.

NOTE:
Improvements on this lot are not in a flood hazard area.

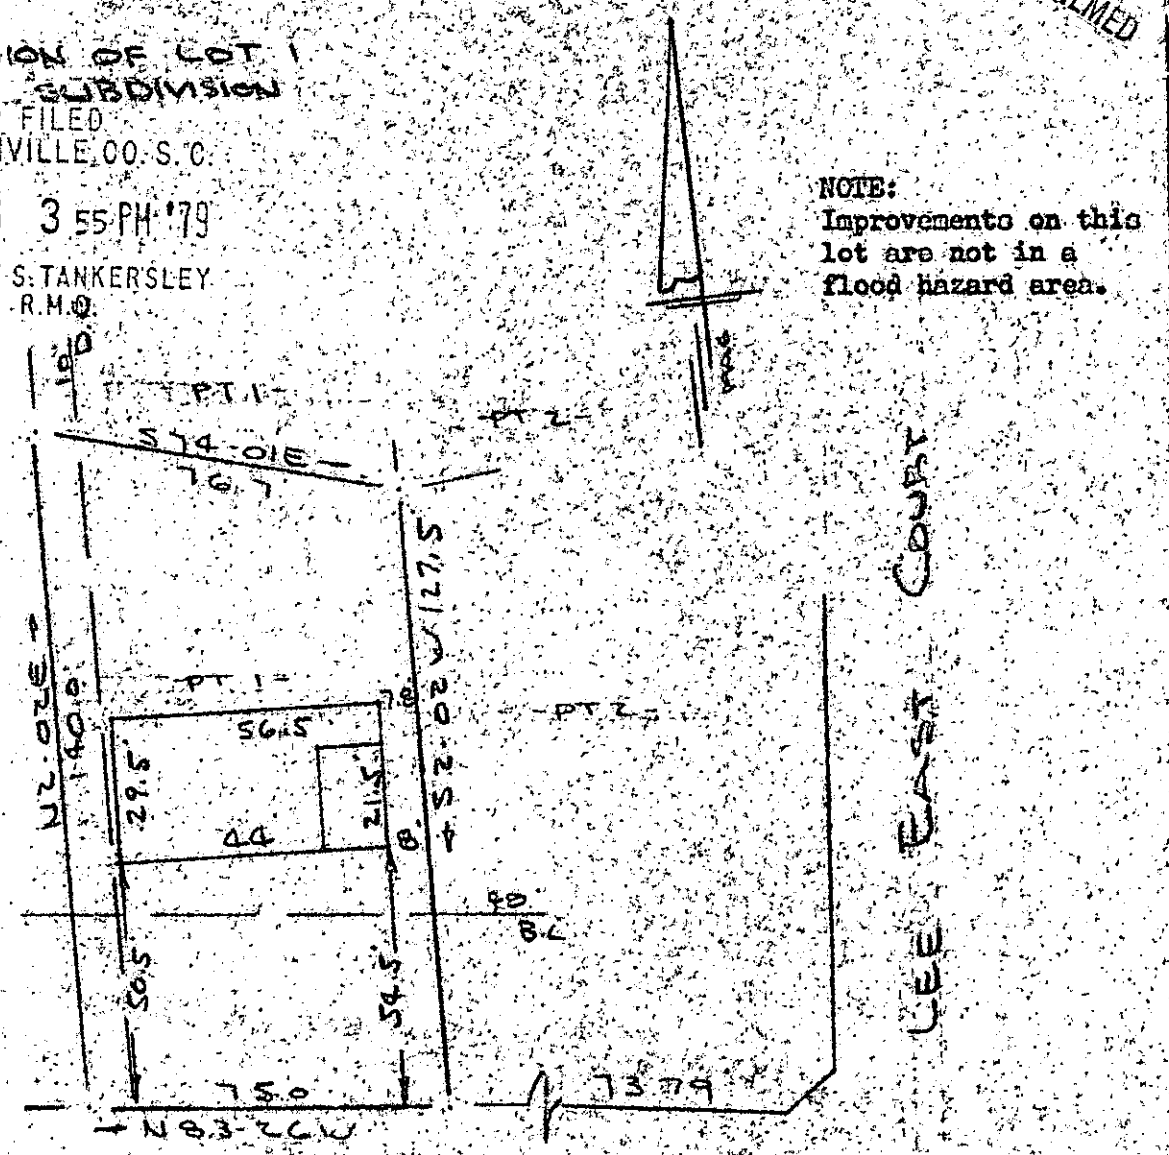

EAST LEE ROAD
PROPERTY OF
JEFFCO ENTERPRISES, INC.
NEAR GREENVILLE, S.C.
SCALE 1" = 40 5 MARCH 1979

This is to certify that on the 5th day of March, 1979, I surveyed the property shown on this plat, being known as part of lot 1 on plat of LEE EAST and recorded in the RMC Office Greenville County, S. C., in Plat Book " 6 - H " at Page 40; and also being known as PROPERTY OF JEFFCO ENTERPRISES, INC. and recorded in Plat Book at Page ; and that the property lines, walls and buildings are as shown hereon, and that the walls and buildings located on said lot do not encroach or project on adjacent street or property, and that no adjacent walls or buildings encroach or project on said premises, and no power lines cross this property except as shown hereon.

25198

R. B. Bruce

R. B. Bruce, RLS #1952

7-B-33

CAROLINA SURVEYING CO.
112 Manly St. Greenville, S. C.

N/B T39.1-1-

13202