


MICROFILMED

FILED
GREENVILLE, CO. S. C.
MAR 9 1 48 PM '79
DONNIE S. TANKERSLEY
R.M.C.

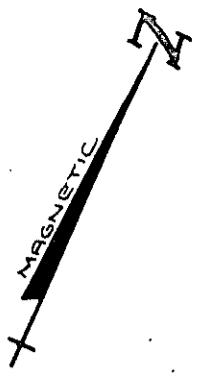

DUKE POWER COMPANY

FERNLEAF DRIVE

N 53-18 E - 116.5
N 52 E
O.I.P. 320' TO WENDFIELD DR.

30' BUILDING LINE

N 36-42 W - 150.0

S 40-56 E - 151.0

-84-

-83-

-85-

S 53-118 W - 140.0

-74-

-73-

-72-

PROPERTY OF
JOHN EDWARD PALMER, JR.
BETTY A. PALMER
TRAVELERS REST GREENVILLE COUNTY
SOUTH CAROLINA

3.1.12.1001 9E


This is to certify that on the 6th day of February, 1979, I surveyed the property shown on this plat; being the same property shown as Lot # 84, Section One, Sunny Slopes, recorded in R.M.C. for Greenville County in Plat Book 4R, Page 3, and that the property lines, walls and buildings are as shown hereon; that the buildings located on said property do not encroach or project on adjacent streets or property except as shown hereon; and that no adjacent buildings or walls encroach or project on said premises. The structures located on this property are not located in an area designated as a flood plain.

25879

W.R. Williams, Jr.

MAR 9 1979

✓ 7-B-45

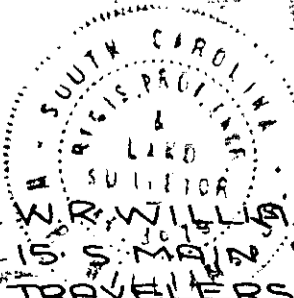

W.R. WILLIAMS, JR. P.E. (S. #3979)
15 S. MAIN ST.
TRAVELERS REST, S.C. F.B. #30 506.8-1-84 SCALE 1"=40'