MICROFILMED

FILED
GREENVILLE CO. S. C.
MAR 12 10 07 AM '79
DONNIE S. TANKERSLEY
R.M.C.

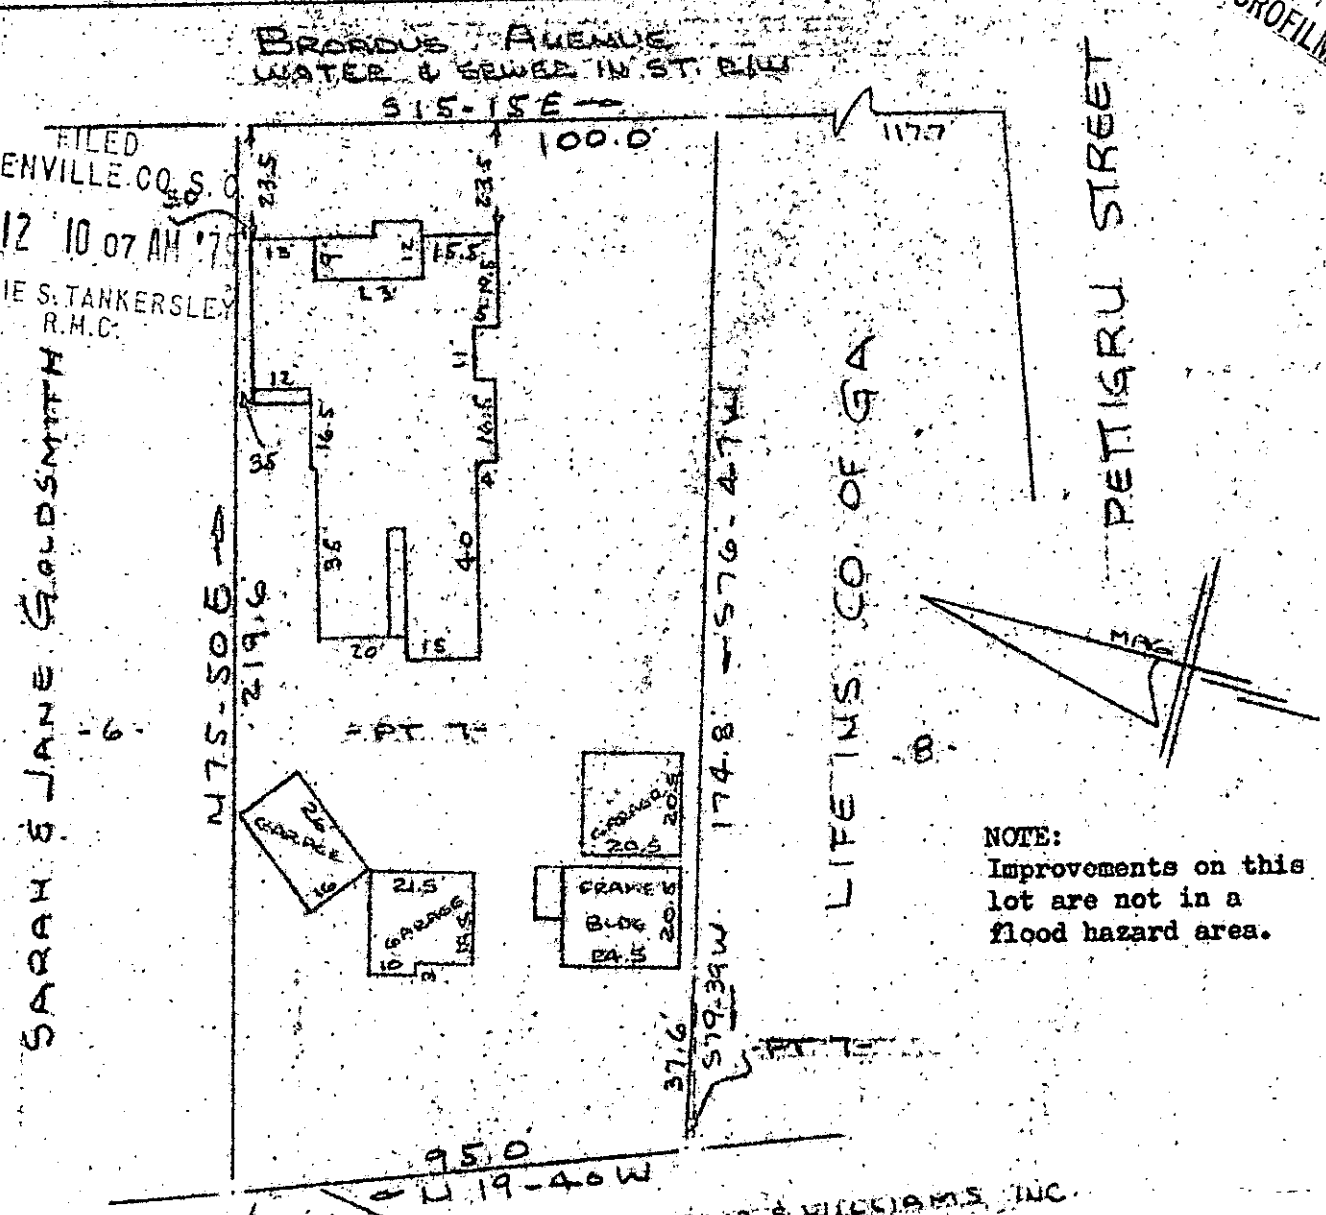

NOTE:
Improvements on this lot are not in a flood hazard area.

PROPERTY OF
PETER J. ASHY
GREENVILLE, S. C.
SCALE 1" = 40' 2 MARCH 1979

This is to certify that on the 2nd day of March, 1979, I surveyed the property shown on this plat, being known as part of lot 7 on plat of BLOCK # 1 BOYCE LAWN ADDITION and recorded in the RMC Office Greenville County, S. C., in Plat Book " A " at Page 90; and that the property lines, walls and buildings are as shown hereon, and that the walls and buildings located on said lot do not encroach or project on adjacent street or property, and that no adjacent walls or buildings encroach or project on said premises, and no power lines cross this property except as shown hereon.

26047

R. B. Bruce

R. B. Bruce, RLS #1952

CAROLINA SURVEYING CO.
Greenville, S. C.

GCTO 1-3 MR12 79 124

1.00CI

17-B-48