MICROFILMED

FILED
GREENVILLE CO. S. C.
MAR 13 4 21 PM '79
DONNIE S. TANKERSLEY
R.M.C.

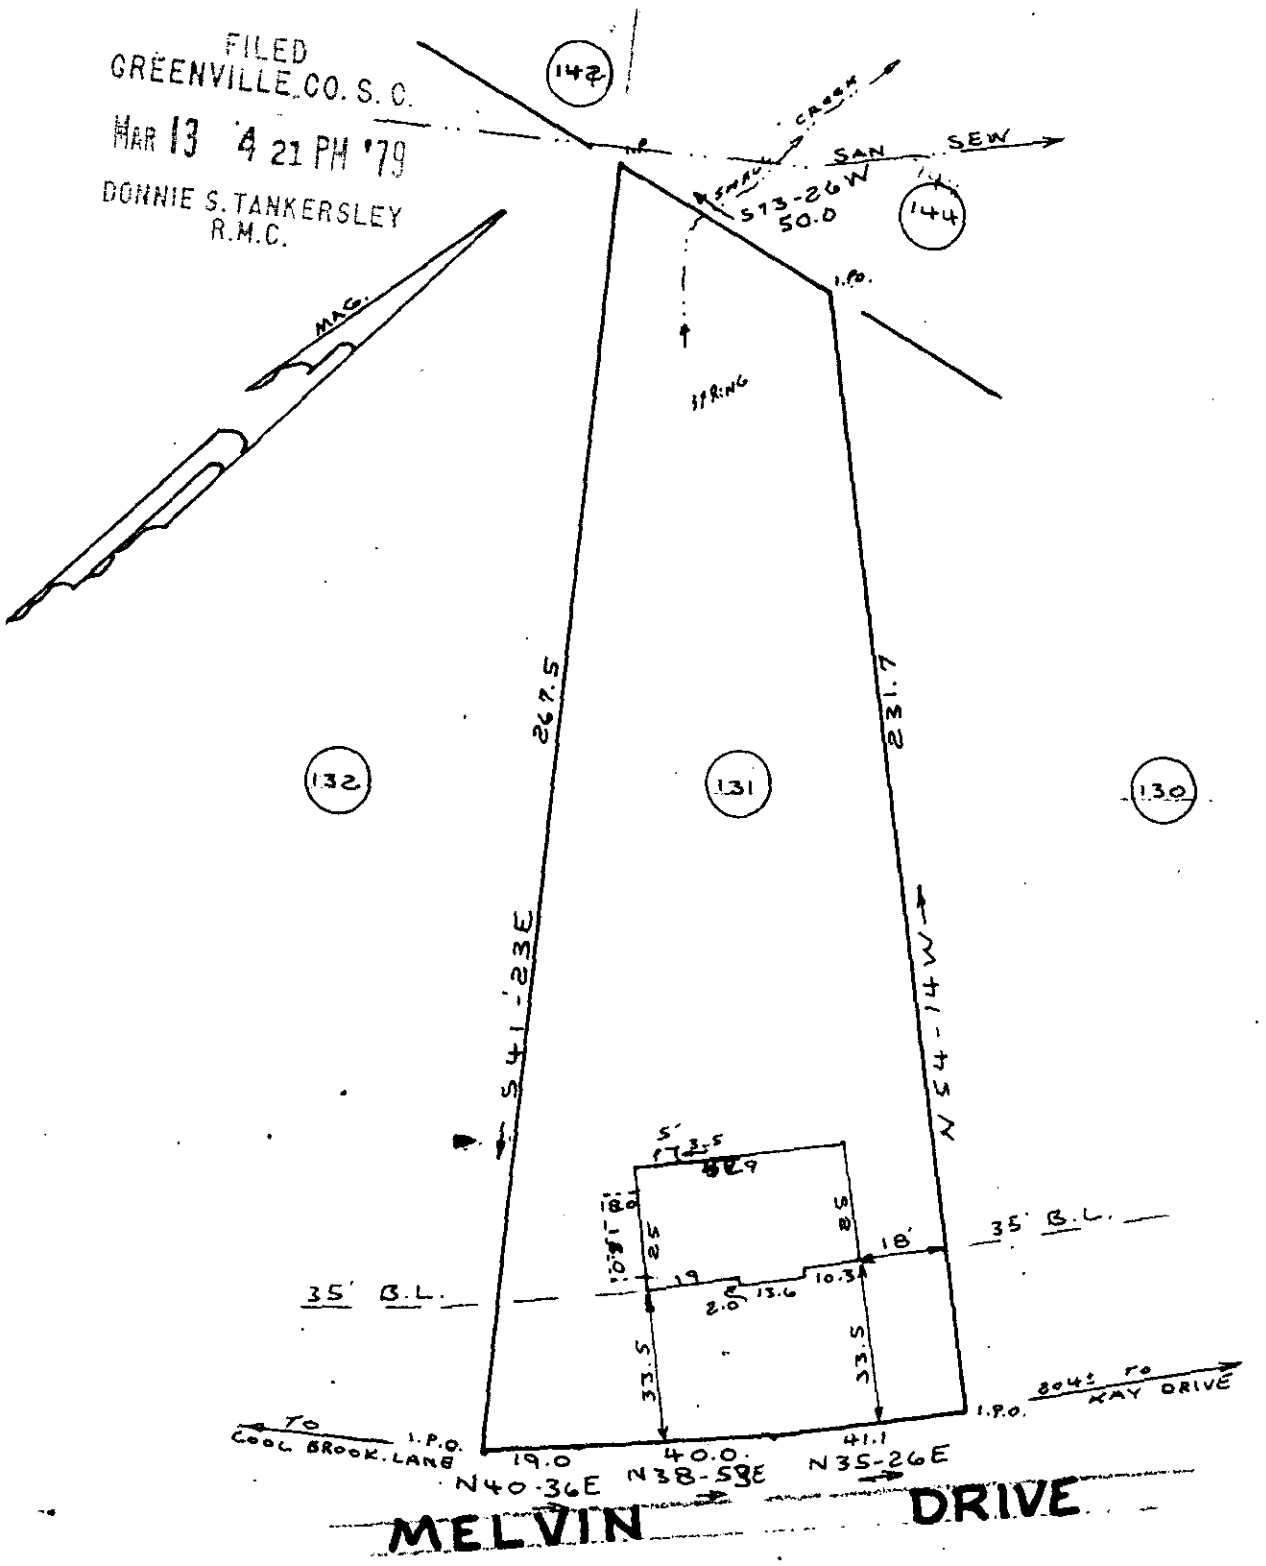

26174

I hereby certify that on March 5 1979 I surveyed lot 131 according to a plat of Belmont Heights section two dated Dec. 1954 and recorded in plat book "EE" on page 181 in the R.M.S. Office Of Greenville County; and that the property lines, buildings and walls are as shown hereon. That no walls or buildings encroach or project on adjacent streets or property and no buildings or wall encroach or project on these premises and the structures are not within a flood area.

Charles F. Webb R.L.S.

CHARLES F. WEBB
REGISTERED
1577
LAND SURVEYOR
SOUTH CAROLINA

7-B-52

PROPERTY OF

WILLIS H. NEWTON

MARY E. NEWTON

NEAR THE CITY OF GREENVILLE

GREENVILLE COUNTY S. C.

WEBB SURVEYING & MAPPING CO.

SCALE 1" = 40' MARCH 5 1979

BLK. BK. REF. 388-G-3