


MICROFILMED

PIEDMONT ST. R/W
WATER IN ST. R/W

N 6-45 E 148.0

102.0
S 4-10 W

WILLIAMS STREET
WATER IN ST. R/W

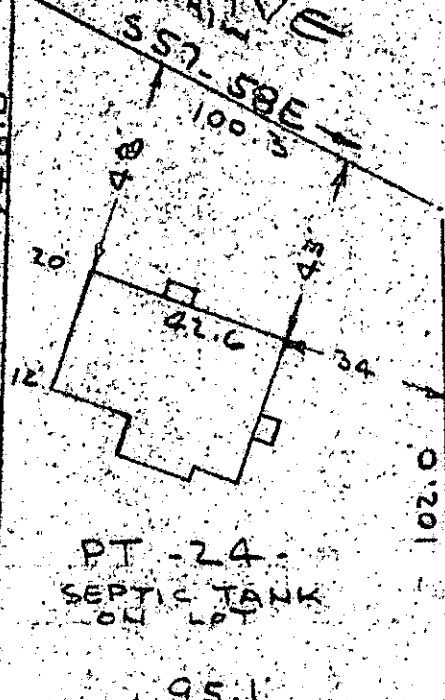

NOTE: Improvements on this lot are not in a flood hazard area.

FILED
GREENVILLE CO. S.C.
MAR 20 4 56 PM '79
DONNIE S. TANKERSLEY
R.M.C.

PROPERTY OF
FRANK WAYNE HEAD & DEBRA A. HEAD
NEAR GREENVILLE, S.C.
SCALE 1" = 40' 19 MARCH 1979

This is to certify that on the 19th day of March, 1979, I surveyed the property shown on this plat, being known as part of lot 24 on plat of MAP OF McCAIN HEIGHTS and recorded in the RMC Office Greenville County, S. C., in Plat Book " J " at Page 59 and also known as PROPERTY OF FRANK WAYNE HEAD & DEBRA A. HEAD and recorded in the RMC Office Greenville County, S. C., in Plat Book at Page and that the property lines, walls and buildings are as shown hereon, and that the walls and buildings located on said lot do not encroach or project on adjacent street or property, and that no adjacent walls or buildings encroach or project on said premises, and no power lines cross this property except as shown hereon.

26917

✓ 7 B - 69

R. B. Bruce
R. B. Bruce, RIS #1952

MAR 20 1979

CAROLINA SURVEYING CO.
112 Manly St.
Greenville, S. C.

206
207
