


MICROFILMED

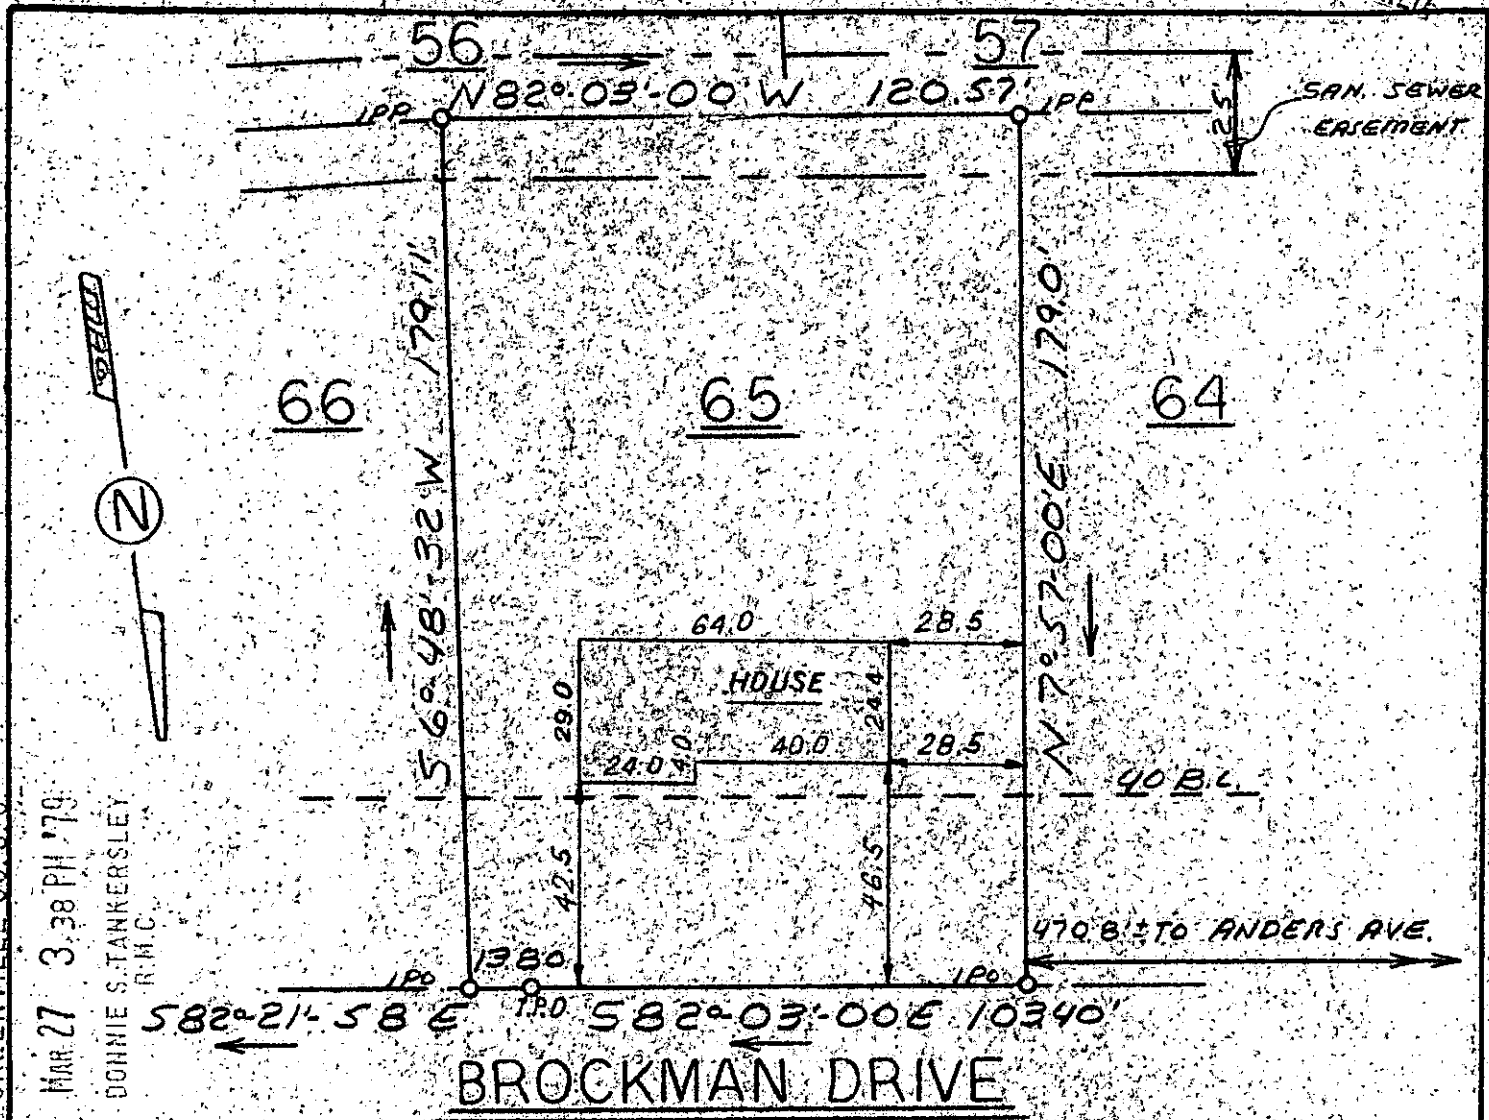

FILED
 GREENVILLE CO. S.C.
 MAR 27 3:38 PM '79
 DONNIE S. TANKERSLEY
 R.M.C.

GC10
 3 MR 27 79
 153

This is to certify that on March 27, 1979, I surveyed the property shown on this plat, known as Lot 65 on Plat of Knollwood Heights, Sec. 5, recorded in the RMC Office of Greenville County in Plat Book 4R on Page 92, and that the property lines, walls and buildings are as shown hereon; that the building located on said lot does not encroach or project on adjacent streets or property, and that no adjacent walls or buildings encroach or project on said premises, and that no utility lines cross this property except as shown hereon. This property is not located in a flood hazard area.

Drainage & Utilities easement 5' each side of all side & rear lot lines.

27692

James R. Freeland

James R. Freeland RLS & PE 4781

MAR 27 1979

7-B-92



STATE OF SOUTH CAROLINA		FREELAND & ASSOCIATES Engineers • Land Surveyors GREENVILLE, S.C.
GREENVILLE COUNTY		
KNOLLWOOD HEIGHTS		SURVEY <i>RP</i>
MAP 2 - SEC. 5 - LOT 65		DRAWN <i>MC</i>
PROPERTY OF		CHECK <i>NRH</i>
GEORGE OSHIELDS BUILDERS		SCALE 1" = 40'
		DATE 2-28-79
		DWG. NO. 79-2923