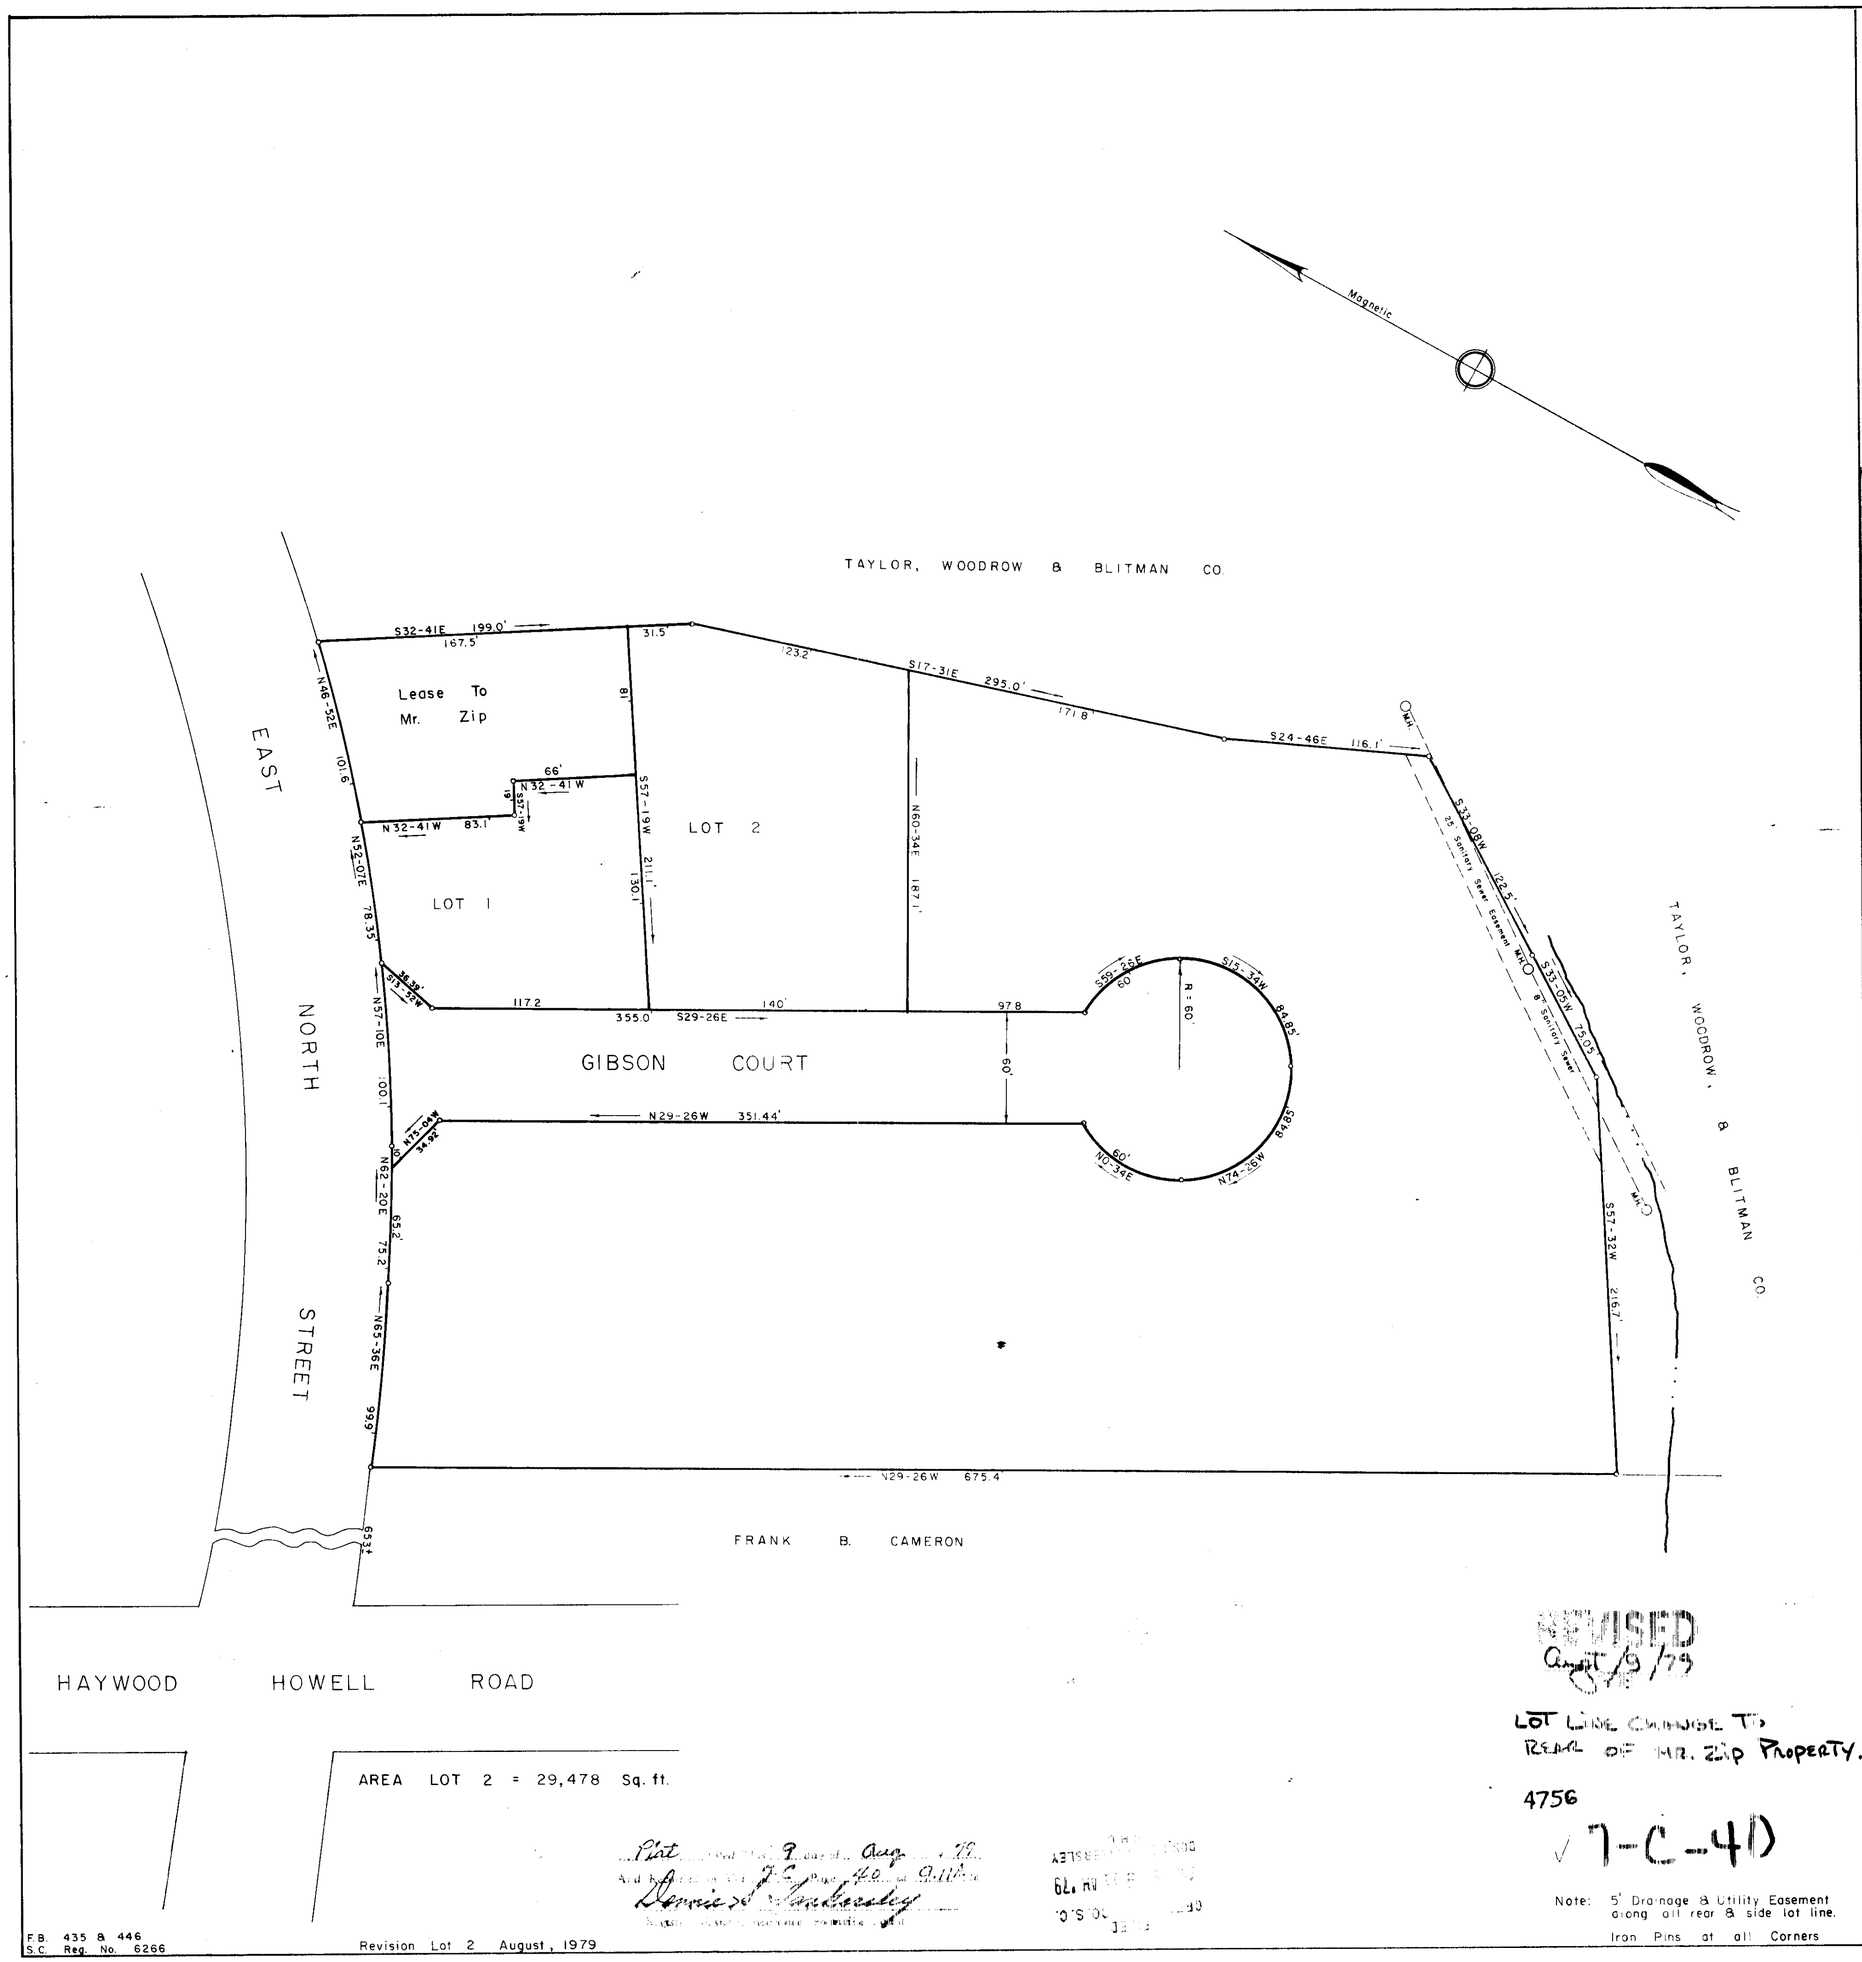

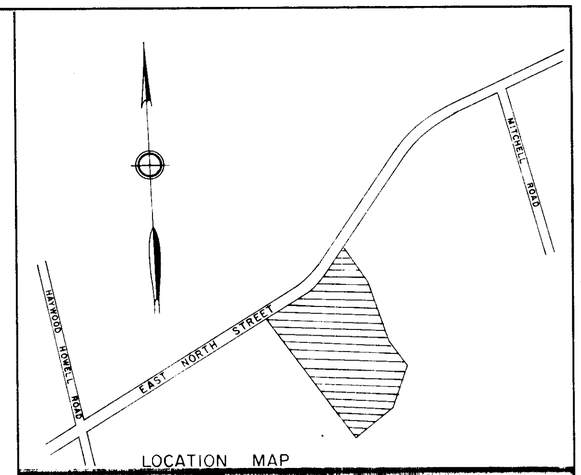

LOCATION MAP

FINAL PLAT

CERTIFICATE OF OWNERSHIP AND DEDICATION

"The undersigned hereby acknowledge that I am (we) the owner(s) of the property shown and described hereon and that I (we) hereby adopt this plan of subdivision with my (our) free consent and that I (we) establish the minimum building restriction lines, and hereby dedicate to public use as roads, streets, and easements, forever all areas shown or indicated on said plat.

7 / 16 / 79 Signed [signature]

___ / ___ / ___ Signed _____

___ / ___ / ___ Signed _____

___ / ___ / ___ Signed _____

CERTIFICATE OF ACCURACY

"I _____ certify that this plat was (drawn by me) (drawn under my supervision) (an actual survey made under my supervision) from (an actual survey made by me) (deed description recorded in Book _____, Page _____, Book _____, Page _____, etc.) (other); that the error of closure as calculated by latitudes and departures is _____, that the boundaries not surveyed are shown as broken lines plotted from information found in Book _____, Page _____; that this plat was prepared in accordance with the Greenville County Subdivision Regulations as adopted.

JULY 16, 1979 — DATE

[signature] — LICENSED ENGINEER OR REGISTERED SURVEYOR

S. C. Registration No. 6266

CERTIFICATE OF APPROVAL FOR RECORDING

"I hereby certify that the subdivision plat shown hereon has been found to comply with the Subdivision Regulations for Greenville County, with the exception of such variances, if any, as are noted in the minutes of the Greenville County Planning Commission of Greenville County, South Carolina, and that it has been approved for recording in the office of the County Register of Mense Conveyance."

Aug 29, 1979 — DATE

[signature] — DIRECTOR OF PLANNING, GREENVILLE COUNTY PLANNING COMMISSION

FILE NUMBER

79-132

GIBSON SQUARE

GIBSON BROS., INC.	DALTON & NEVES CO.
OWNER	ENGINEERS

NO. OF ACRES 6.04 — MILES OF NEW ROAD 0.09

NO. OF LOTS 4 — DATE July, 1979

ZONED C-1

SCALE 1" = 50'

50 0 50 100

REVISED Aug 9/79

LOT LINE CHANGE TO REAR OF MR. ZIP PROPERTY.

4756

√ 7-C-40

Note: 5' Drainage & Utility Easement along all rear & side lot line.

Iron Pins at all Corners

Plat [illegible] 9 day of Aug 79

And Recorded in [illegible] J.C. Page 40 of 9.11

[signature]

F.B. 435 & 446
S.C. Reg. No. 6266

Revision Lot 2 August, 1979

