


This is to certify that on March 29, 1979, I surveyed the property shown on this plat, known as Lot 3 and Part Lot 2 on Plat of Cottingham and Zimmerman Property, recorded in the RMC Office of Greenville County in Plat Book E on Page 135, and that the property lines, walls and buildings are as shown hereon; that the building located on said lot does not encroach or project on adjacent streets or property, and that no adjacent walls or buildings encroach or project on said premises, and that no utility lines cross this property except as shown hereon. This property is not located in a designated flood hazard area.

APR 2 1979

James R. Freeland
James R. Freeland RLS & PE 4781

7-D-14 28441

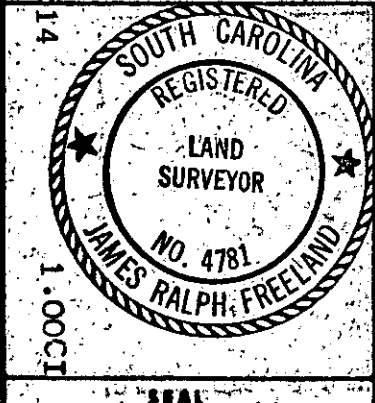

**STATE OF SOUTH CAROLINA
GREENVILLE COUNTY**

PROPERTY OF
RICKY N. PASSMORE
JULIE O. PASSMORE

FREELAND & ASSOCIATES
Engineers • Land Surveyors

GREENVILLE, S. C.

SURVEY	JRF
DRAWN	LD
CHECK	MC
SCALE	1" = 30'
DATE	3-29-79
DWG. NO.	79-3107