MICROFILMED

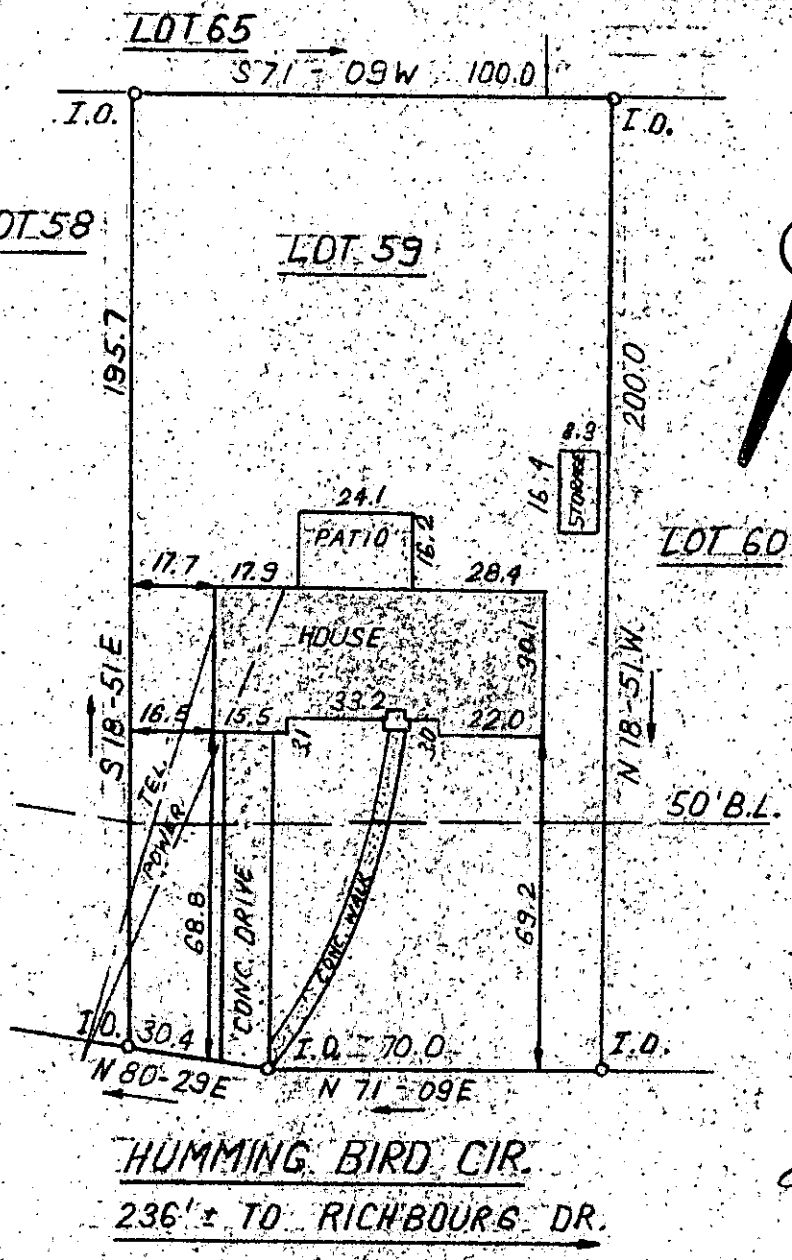

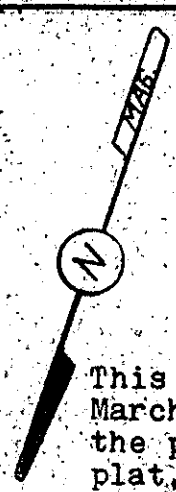

This is to certify that on March 28, 1979, I surveyed the property shown on this plat, known as Lot 59 on Plat of Wade Hampton Terrace, recorded in the RMC Office of Greenville County in Plat Book KK on Page 15, and that the property lines, walls and buildings are as shown hereon; that the building located on said lot does not encroach or project on adjacent streets or property, and that no adjacent walls or buildings encroach or project on said premises, and that no utility lines cross this property except as shown hereon. This property is not located in a designated flood hazard area.

James R. Freeland

James R. Freeland RLS & PE 4781

FILED
GREENVILLE CO. S.C.
APR 5 11 46 AM '79
DONNIE S. TANKERSLEY
R.M.C.

APR 5 1979

28888 ✓ 7-D-28

SOUTH CAROLINA
REGISTERED
LAND SURVEYOR
NO. 4781
JAMES RALPH FREELAND

SEAL

STATE OF SOUTH CAROLINA
GREENVILLE COUNTY

WADE HAMPTON TERRACE
LOT 59
PROPERTY OF
HELEN G. CANNON

GCTO ——— 2 AP 5 79 ——— 531

FREELAND & ASSOCIATES
Engineers • Land Surveyors
GREENVILLE, S.C.

SURVEY	D.H.
DRAWN	B.R.
CHECK	MC
SCALE	1" = 40'
DATE	MARCH 28.79
DWG. NO.	79-3101

1.00CI