MICROFILMED

FILED
GREENVILLE CO. S. C.
APR 5 3 32 PM '79
DONNIE S. TANKERSLEY
R.M.C.

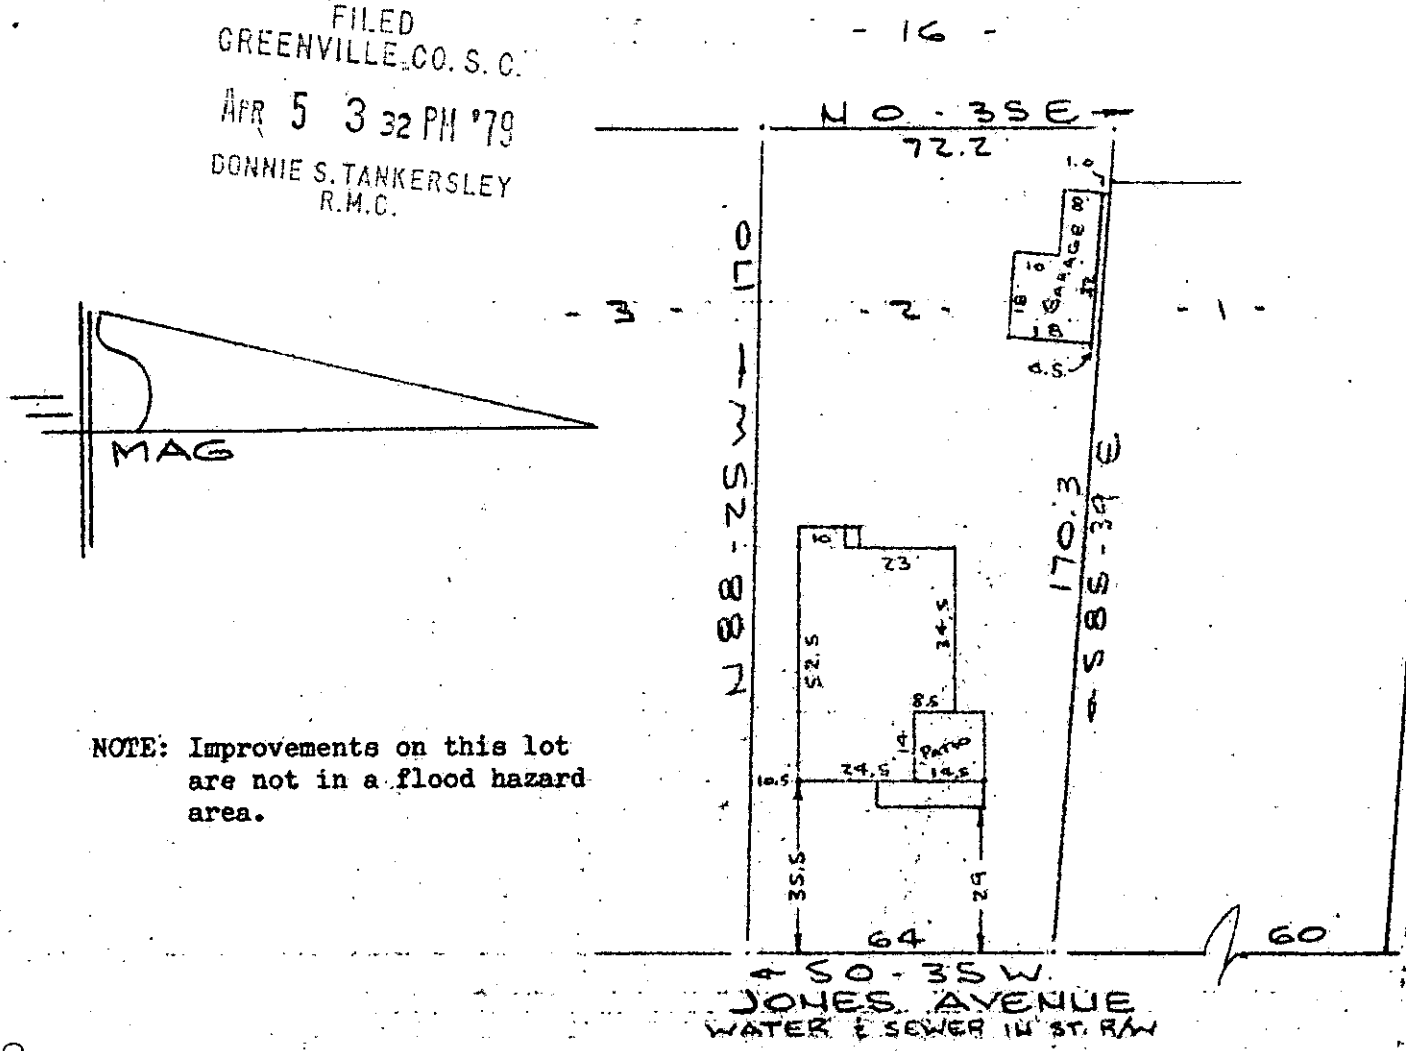

NOTE: Improvements on this lot are not in a flood hazard area.

PROPERTY OF
PAUL W. CURLEE & JESSICA R. CURLEE
GREENVILLE, SOUTH CAROLINA
SCALE: 1" = 40' 5 APR 1979

This is to certify that on the 5th day of April, 1979, I surveyed the property shown on this plat, being known as lot 2 on plat of PROPERTY OF MRS. S. K. TINDAL and recorded in the RMC Office Greenville County, S. C., in Plat Book " G " at Page 247; and that the property lines, walls and buildings are as shown hereon, and that the walls and buildings located on said lot do not encroach or project on adjacent street or property, and that no adjacent walls or buildings encroach or project on said premises, and no power lines cross this property except as shown hereon.

Also being known as PROPERTY OF PAUL W. CURLEE & JESSICA R. CURLEE recorded in Plat Book at Page .

R. B. Bruce

R. B. Bruce, RLS #1952

28892

7-D-30

CAROLINA SURVEYING CO.
112 Manly St.
Greenville, S. C.

GCTC --- 1 AP 5 79 158 1.00CI