To Be Recorded

MICROFILMED

NOTE: R/W OF P&N RAILROAD NOT SHOWN ON THIS PLAT.

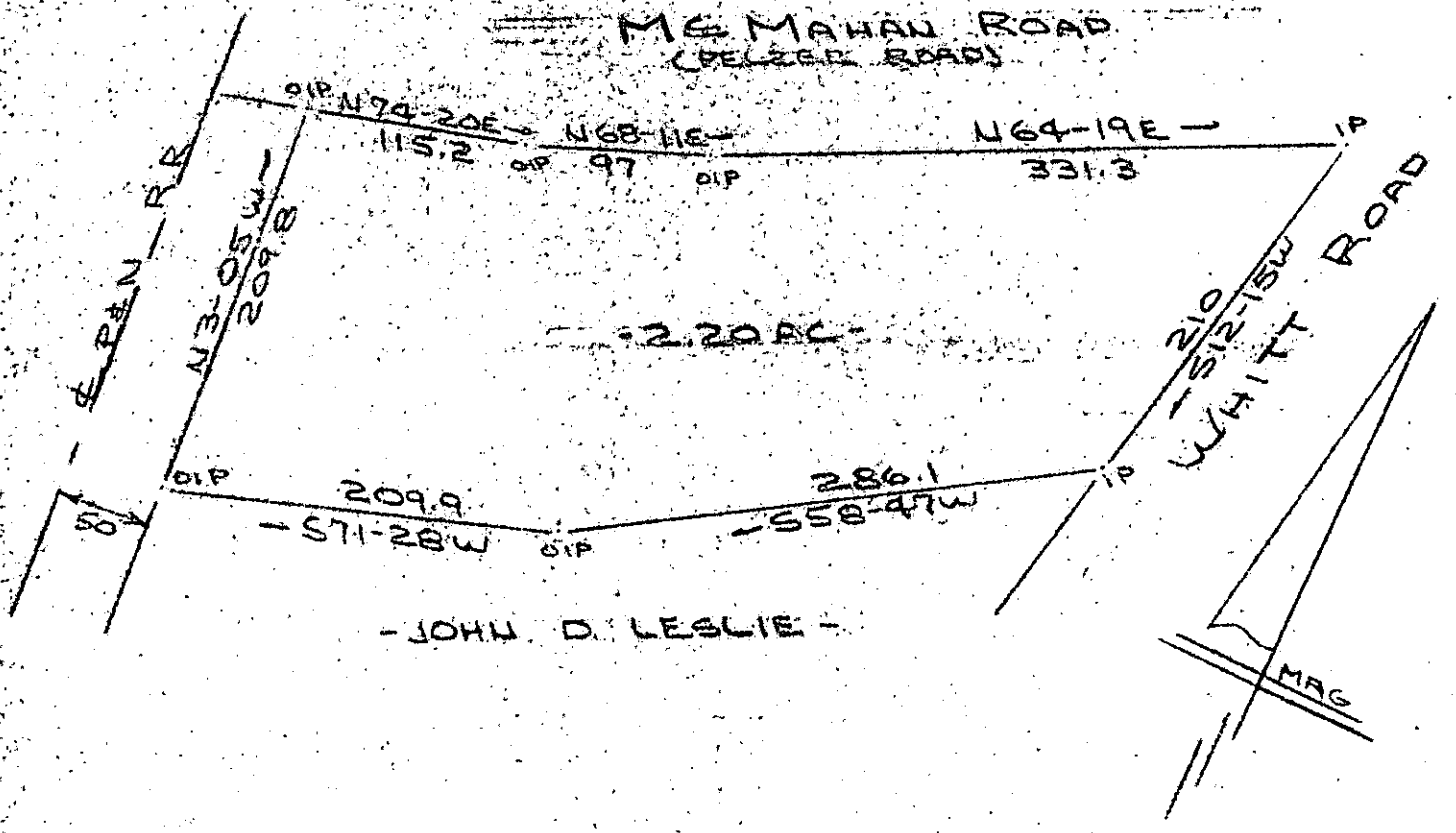

SURVEY FOR

JAMES G. HALL & SANDRA L. HALL

NEAR GREENVILLE, S.C.

SCALE: 1"=100 29 MAR 979

FILED
APR 17 1979
DONNIE S. TANKERSLEY
R.M.C.

APR 17 1979

7-D-67

30130

SOUTH CAROLINA REGISTERED No. 1952 LAND SURVEYOR R. B. BRUCE

CAROLINA SURVEYING
112 MANLY ST.
GREENVILLE, S.C.

R. B. Bruce #1952

GCTC --- 1 AP1779 1124

1.00CT

219/61

FT 611.2-1-6