

LOT 275

FILED
GREENVILLE CO. S. C.
JUN 29 1 21 PM '79

DONNIE S. TANKERSLEY
B.M.C.

LOT 42

LOT 43

CHAIN LINK FENCE
ENCROACHES APPROX.
5' AT THIS POINT



CHAIN LINK FENCE

CHAIN LINK FENCE


BRICK WALL

LOT 276-A

NOTE:
10' DRAINAGE AND UTILITY EASEMENT
ALONG ALL SIDE AND REAR LOT LINES

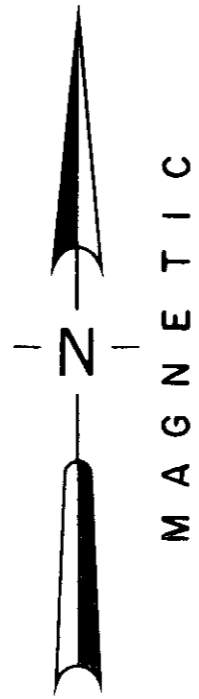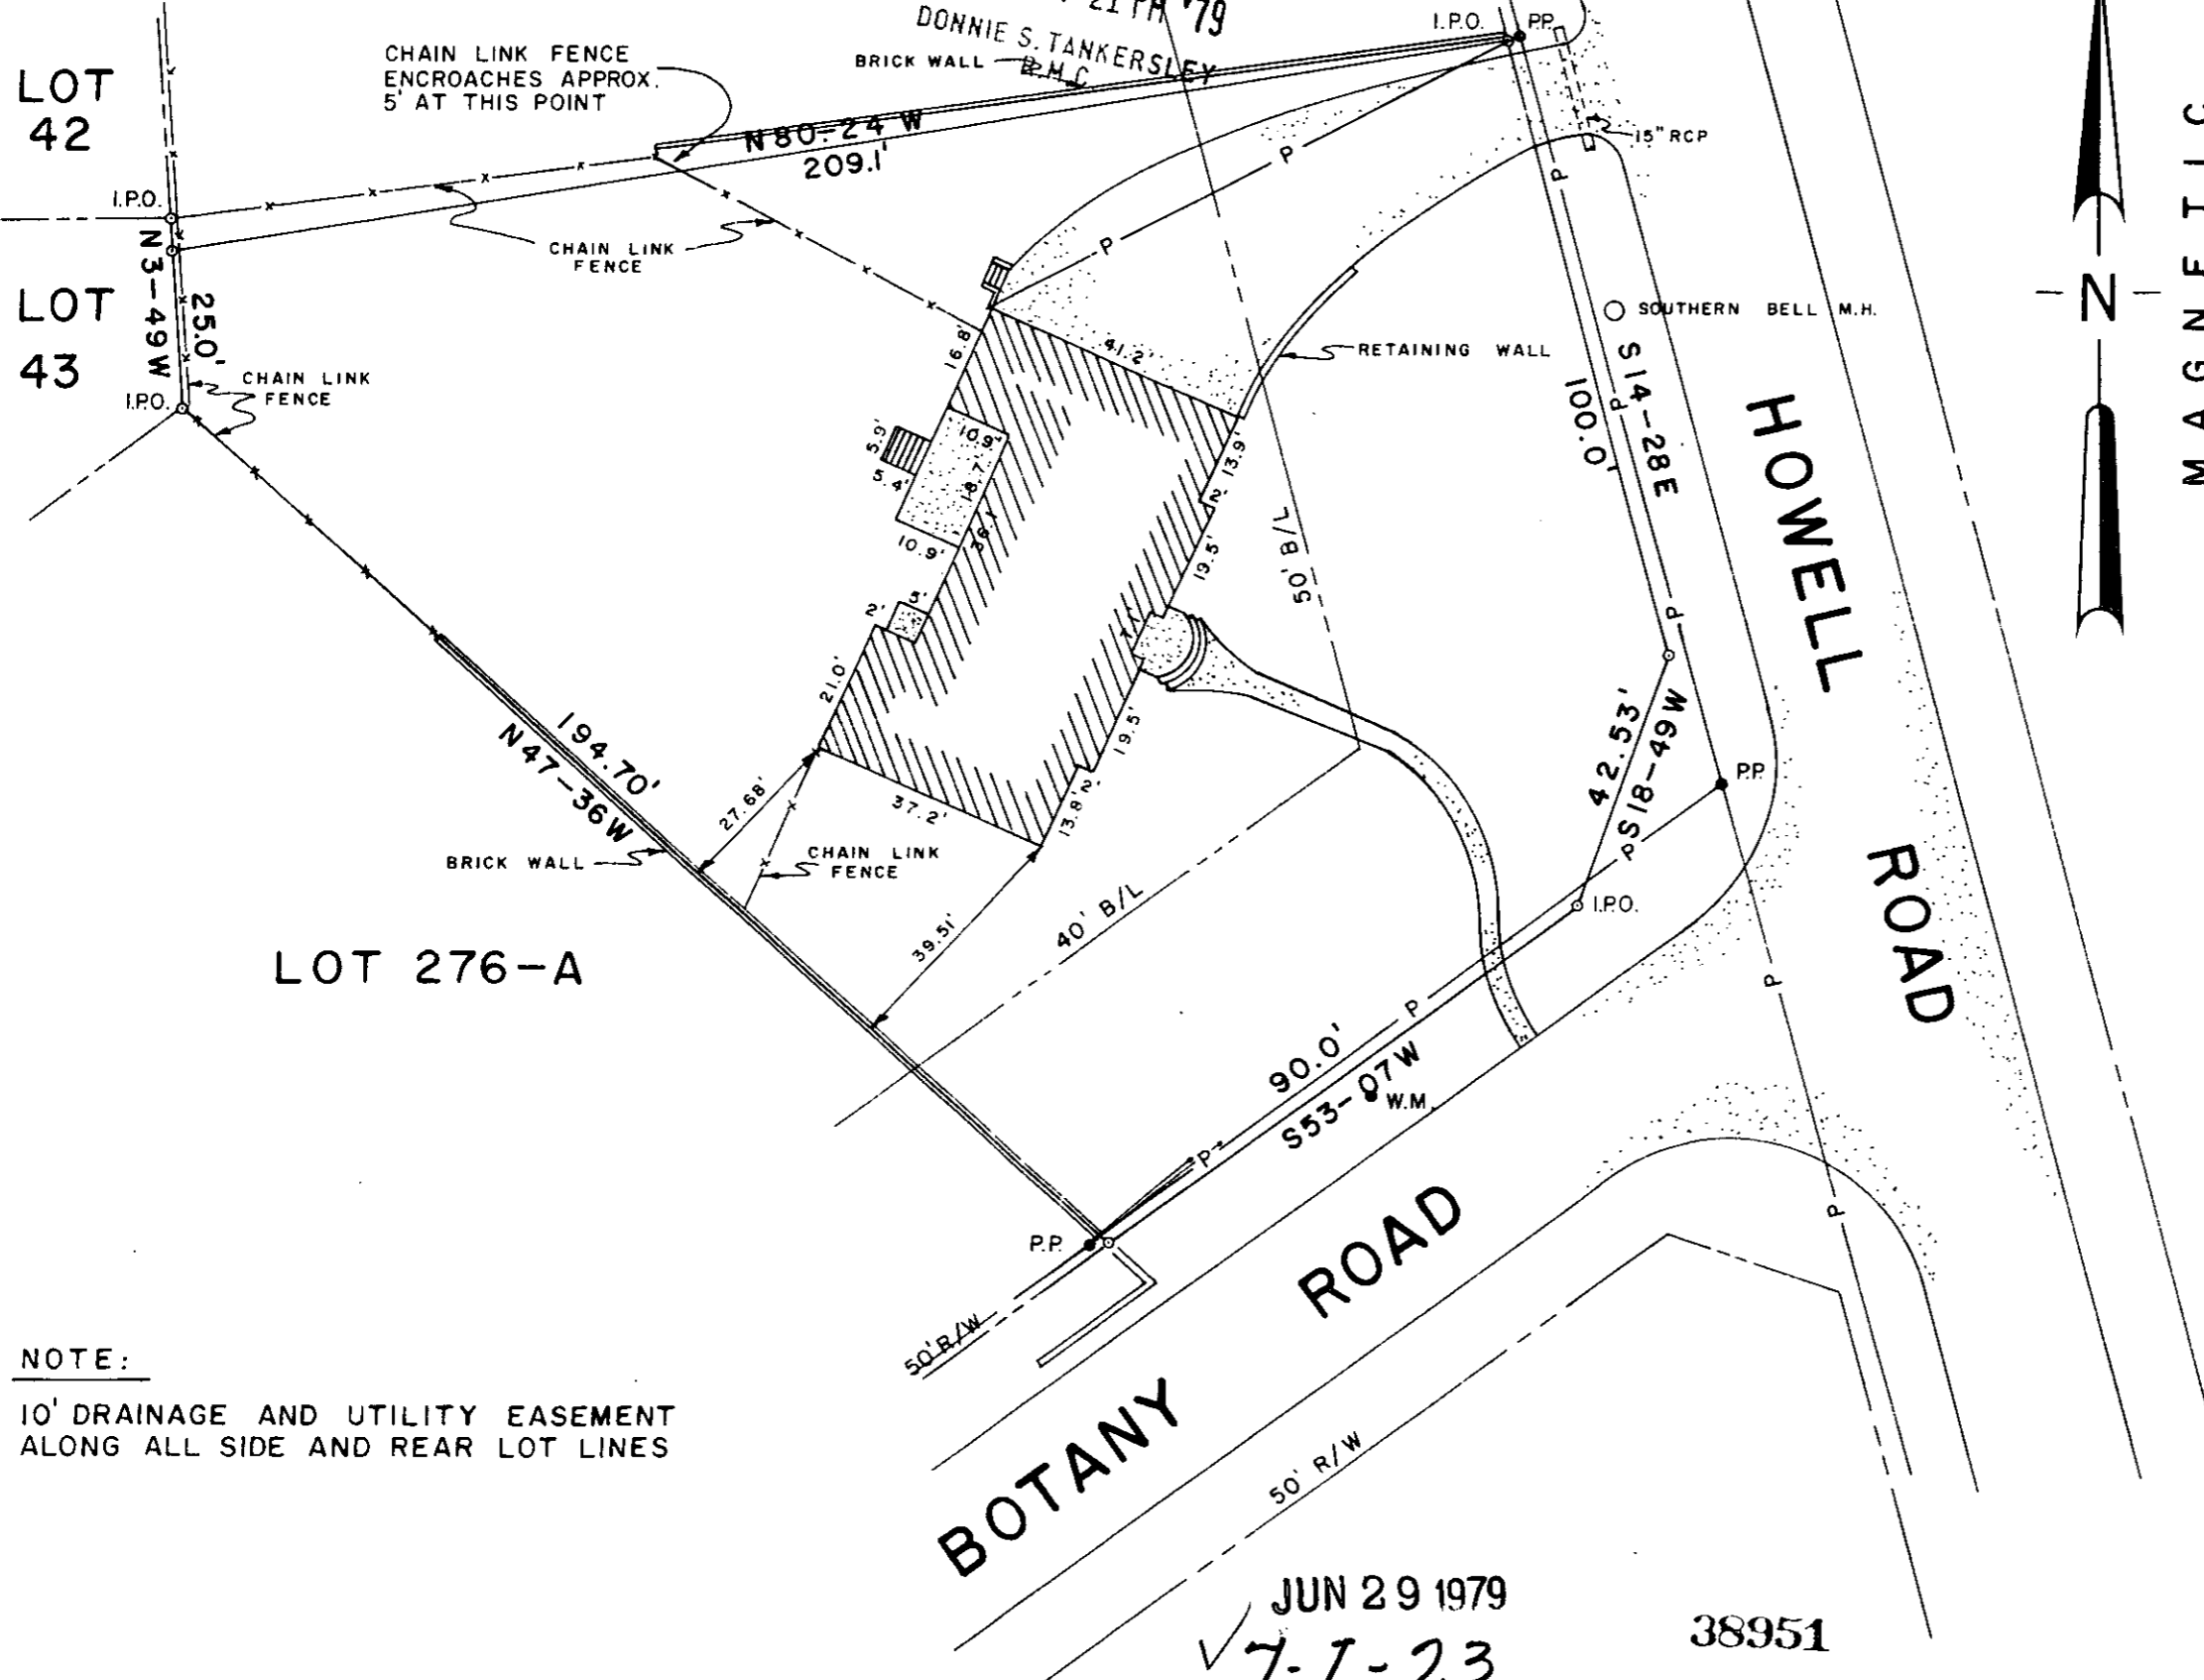

LOCATION MAP

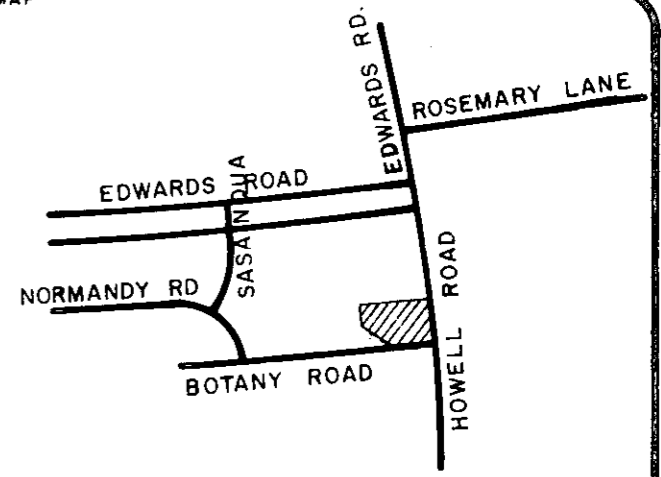


CERTIFICATION

I hereby certify that the measurements as shown on this plat are correct and that there are no encroachments or projections other than shown. This lot is not in a flood plain.

William N. Spann
SIGNATURE

7261
REG. NUMBER

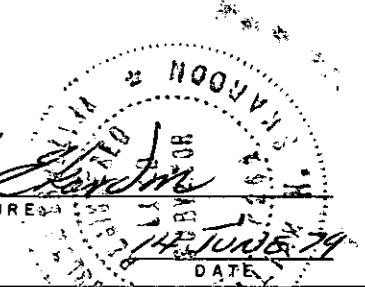

REFERENCES

YY-131		
882-127		
939-196		

FOUNDATION SURVEY FOR
DONALD C. SPANN
BETTY JO SPANN

LOT 276
BOTANY WOODS SUBDIVISION

GREENVILLE SOUTH CAROLINA

GRAPHIC SCALE 0 30 60
1" = 30'

DRAWN	DESIGN	CHECK	DATE	SCALE
WNS	WNS	WNS	14 JUNE 79	1" = 30'

FILE	JOB NO.
	79001-76

ARBOR ENGINEERING

P.O. BOX 263, GREENVILLE, S.C.
LANDSCAPE ARCHITECTS ENGINEERS LAND SURVEYORS

JUN 29 1979
7-1-23

38951

20 25 29 E 200 A4

MICROFILMED