
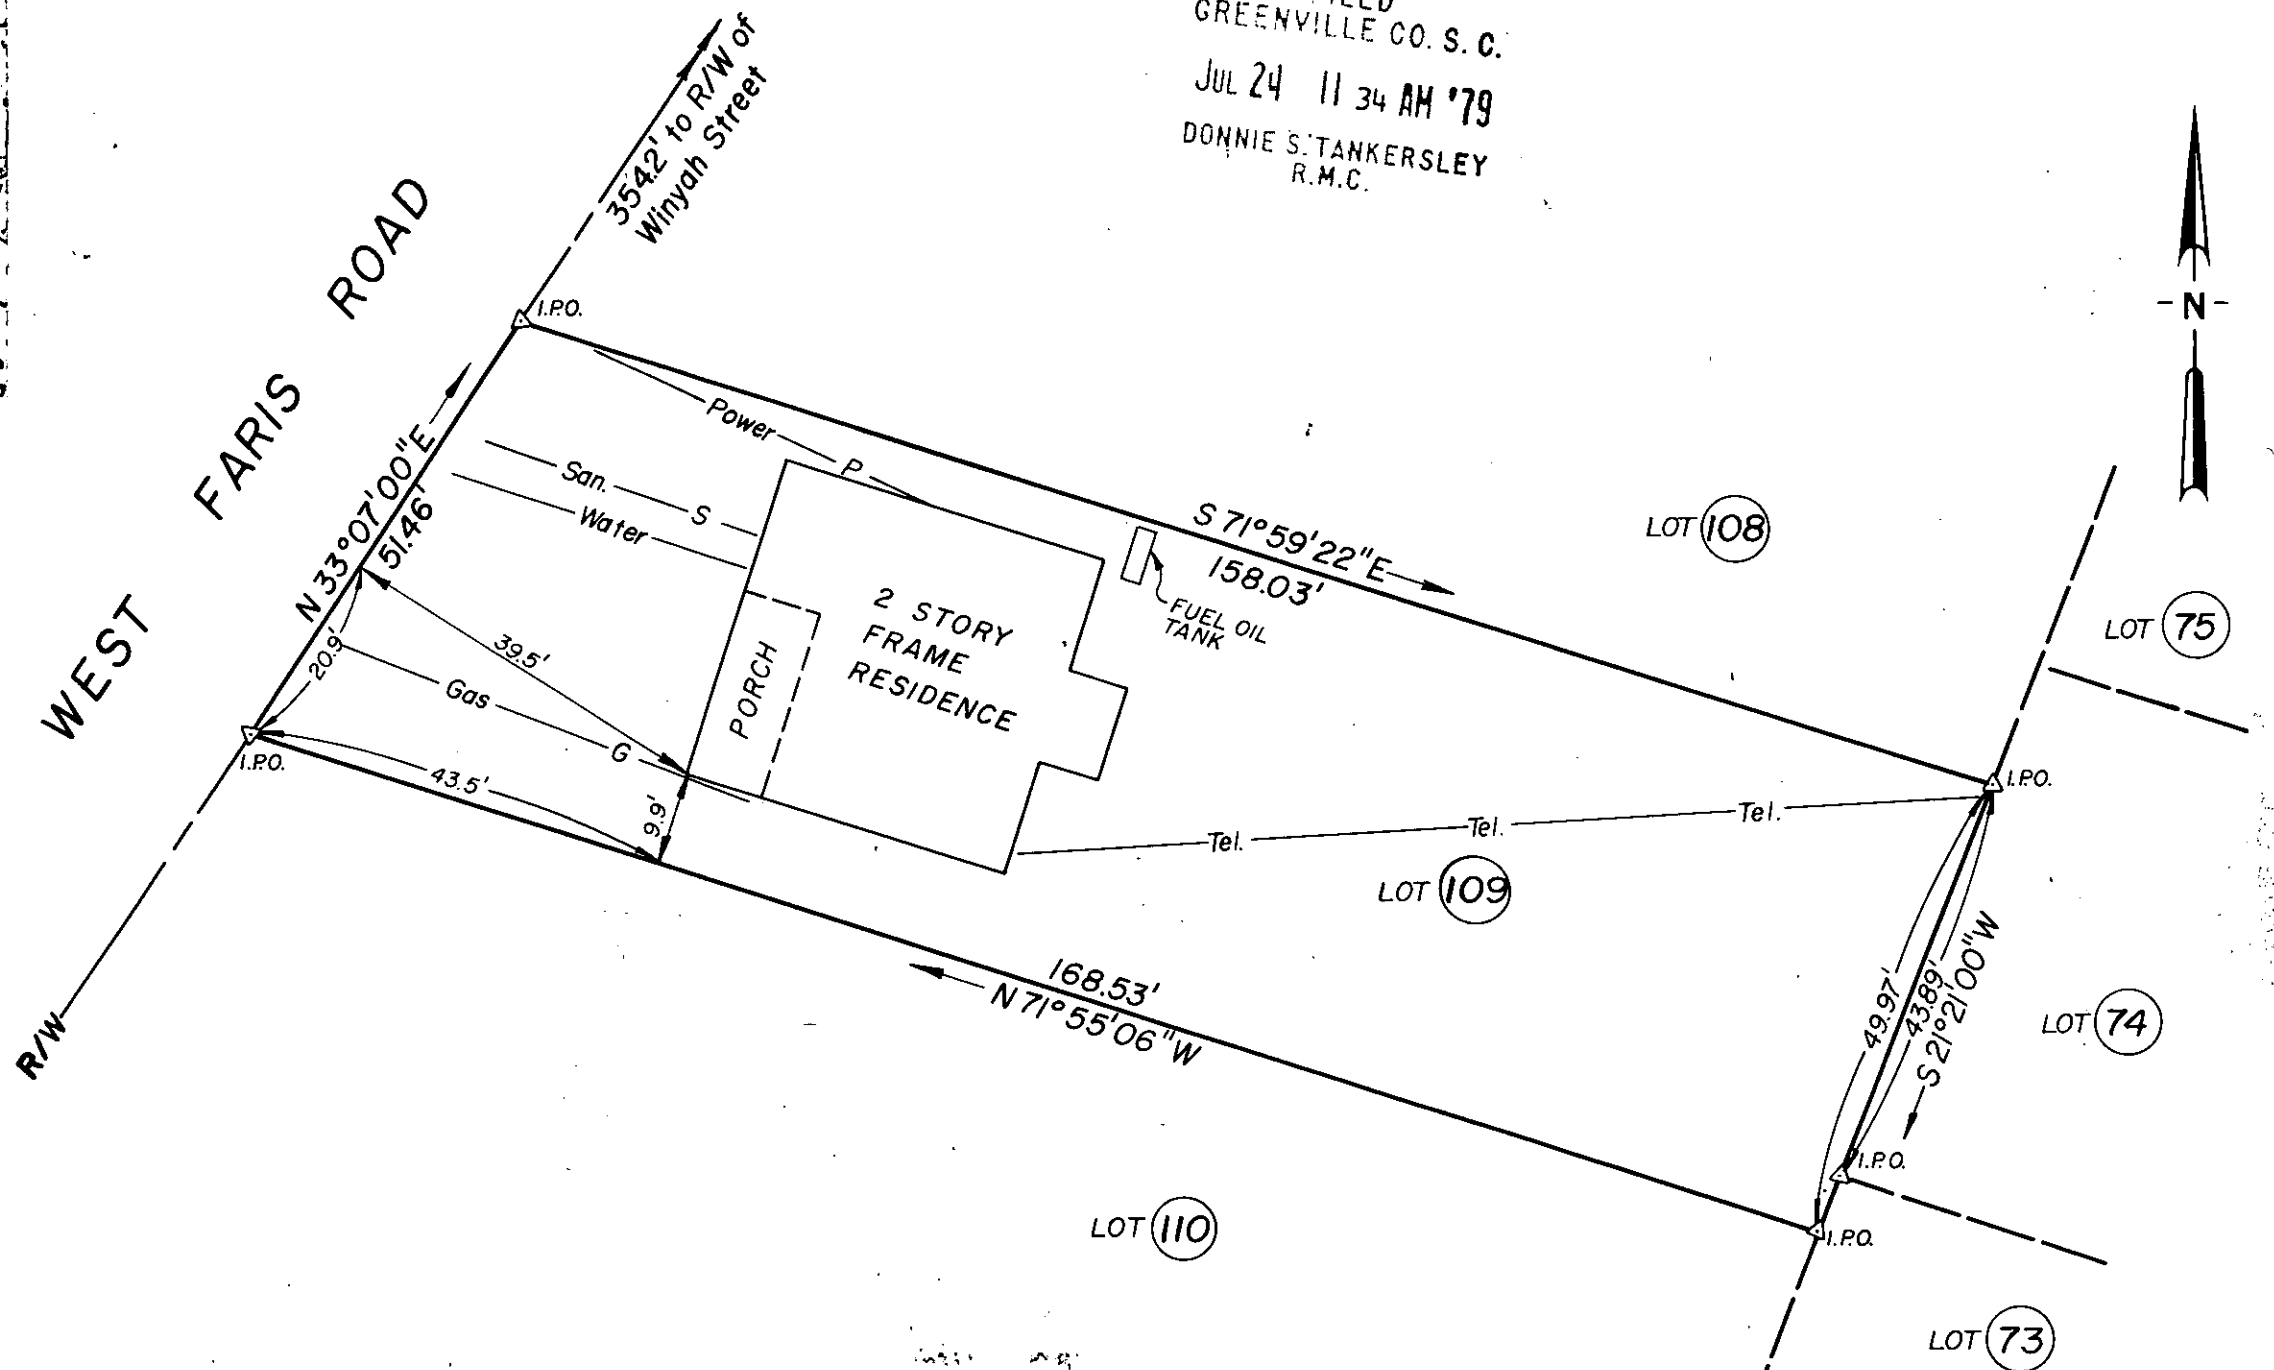


NOTES:


FILED
GREENVILLE CO. S. C.
JUL 24 11 34 AM '79
DONNIE S. TANKERSLEY
R.M.C.

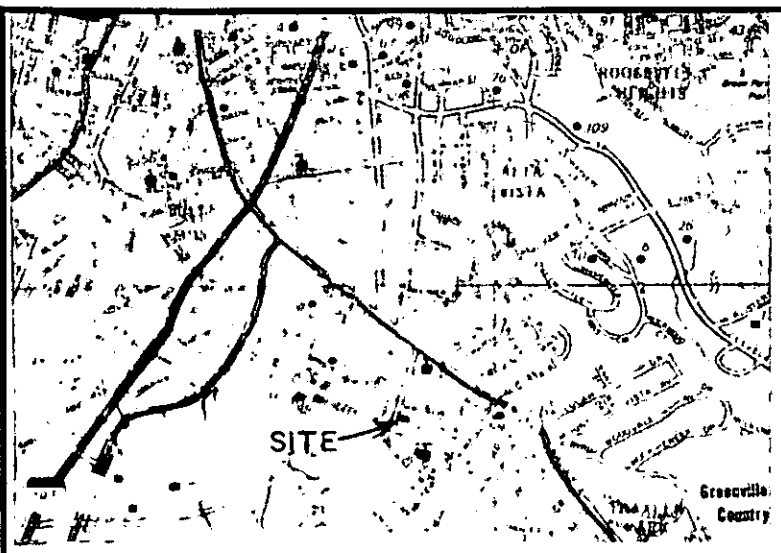

I HEREBY CERTIFY THAT THE RATIO OF PRECISION OF THE FIELD SURVEY IS 1/10,200 AS SHOWN HEREON AND THE AREA WAS DETERMINED BY D.M.D. METHOD OF AREA CALCULATION.


George W. Oneill 7382
SURVEYOR'S SIGNATURE S.C. REG. NO.

JUL 24 1979
7-1-50

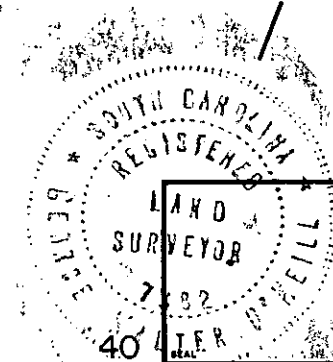

7-1879	WHP	FOR APPROVAL	
REV.	DATE	BY	DESCRIPTION
REVISION			

SURVEY FOR:
RALPH LEE GARNER, JR.
LOT NO. 109
AUGUSTA CIRCLE SUB-DIVISION
217 WEST FARIS ROAD
GREENVILLE, SOUTH CAROLINA

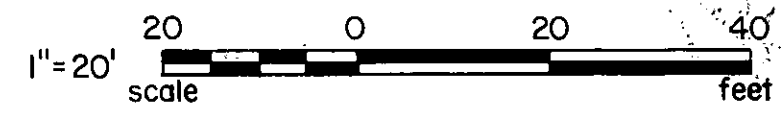

enwright associates, inc.
engineers planners surveyors
GREENVILLE, SOUTH CAROLINA

WHP	TMA	TMA	FILE	RETIRED
7-1879	7-1879	1 1/2 20'	79506	
DATE	SCALE	NO. NO.		

SC10 2 JUL 24 79 754 2.00CI