


JUL 5 1979

GREENVILLE CO. S. C.

JUL 5 11 59 AM '79

805

DONNIE S. TANKERSLEY R.M.C. RICHMOND DRIVE WATER & SEWER IN ST. R/W

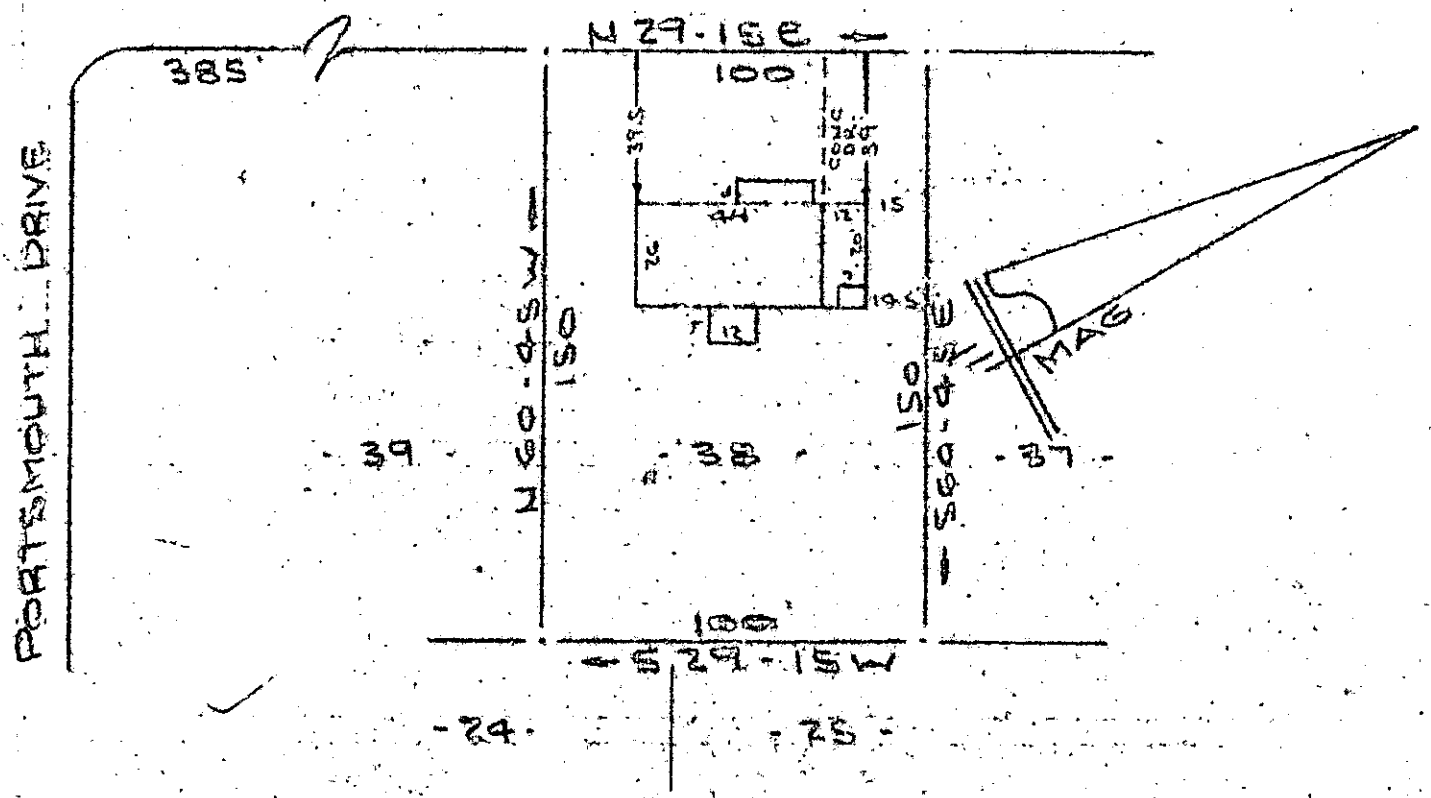

PROPERTY OF  
**BILLY J. JOHNSON**  
 NEAR GREENVILLE, S. C.  
 SCALE: 1" = 50' 19 JUNE 1979

GCTO  
 1 JUL 5 79  
 552  
 1.000CI

This is to certify that on the 19th day of June, 1979, I surveyed the property shown on this plat, being known as lot 38 on plat of SECTION 1 RICHMOND HILLS and recorded in the REC Office Greenville County, S. C., in Plat Book " JJJ " at Page 81; and that the property lines, walls and buildings are as shown hereon, and that the walls and buildings located on said lot do not encroach or project on an adjacent street or property, and that no adjacent walls or buildings encroach or project on said premises, and no power lines cross this property except as shown hereon.

7-2-1

*R. B. Bruce*  
 R. B. Bruce, RLS 1972

CAROLINA SURVEYING CO.  
 112 Manly St.  
 Greenville, S. C.

