

JUL 6 1979

FILED
GREENVILLE CO. S. C.

JUL 6 3 21 PM '79


DONNIE S. TANKERSLEY
R.M.C.

NOTE: Improvements on this lot are not in a flood hazard area.

MAG.

PHILLIPS
WATER IN ST

TRAIL
R/W

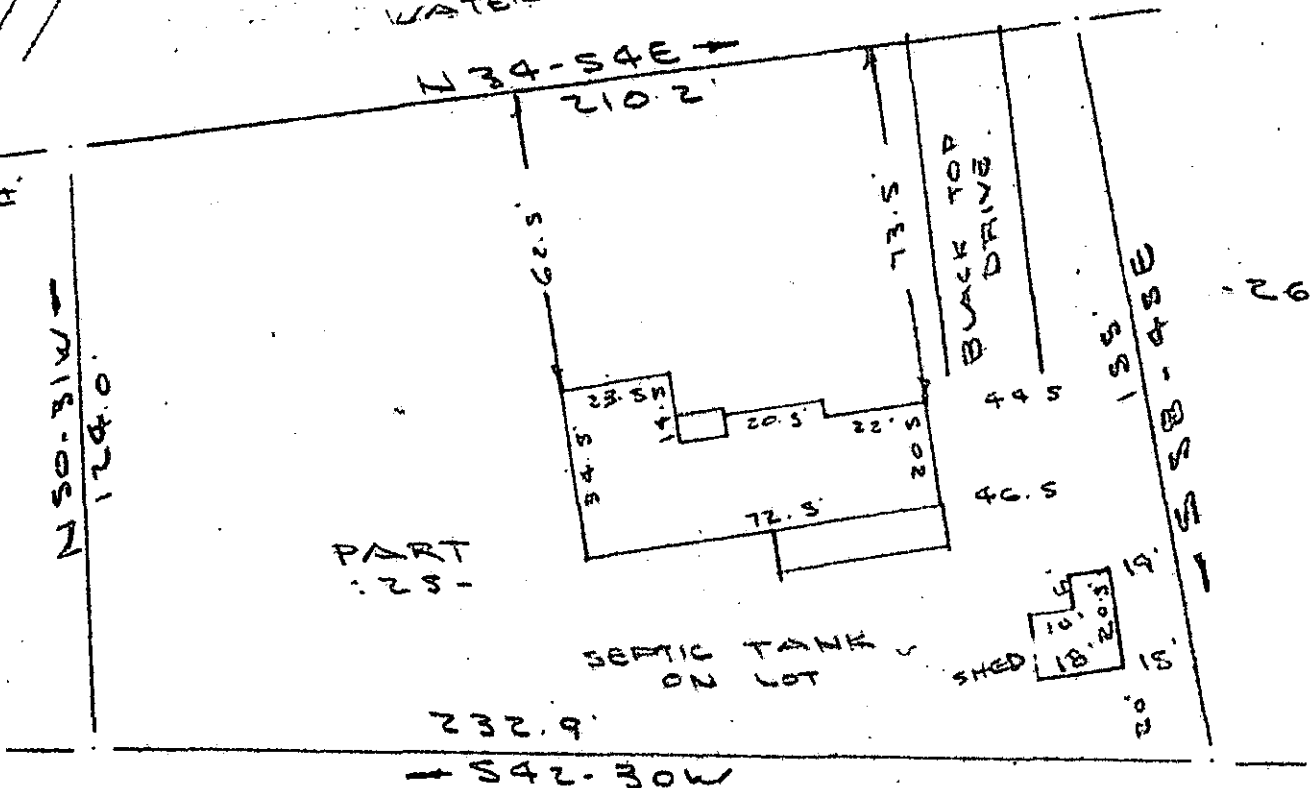

- N/F BREWER -

PROPERTY OF
ROBERT DAVID ROE & MARY JEAN HORNEY
NEAR GREENVILLE, S. C.
SCALE: 1" = 40' S. JULY 1979

This is to certify that on the 5th day of July, 1979, I surveyed the property shown on this plat, being known as part of lot 25 on plat of LEE P. RAMSAY PROPERTY and recorded in the RMC Office Greenville County, S. C., in Plat Book "S" at Page 117; and that the property lines, walls and buildings are as shown hereon, and that the walls and buildings located on said lot do not encroach or project on adjacent street or property, and that no adjacent walls or buildings encroach or project on said premises, and no power lines cross this property except as shown hereon.

7-9-14

691

R. B. Bruce

R. B. Bruce, RLS #1988

CAROLINA SURVEYING CO.

112 Italy Ct.

Greenville, S.C. 29616 79 299

1.0001