


This is to certify that on July 17, 1979, I surveyed the property shown on this plat, known as Lot 55 on Plat of Edwards Forest Heights, recorded in the RMC Office of Greenville County in Plat Book 000 on Page 87, and that the property lines, walls and buildings are as shown hereon; that the building located on said lot does not encroach or project on adjacent streets or property, and that no adjacent walls or buildings encroach or project on said premises, and that no utility lines cross this property except as shown hereon. This property is not located in a designated flood hazard area.

James R. Freeland
James R. Freeland RLS & PE 4781

2378

JUL 20 1979

7-2-79

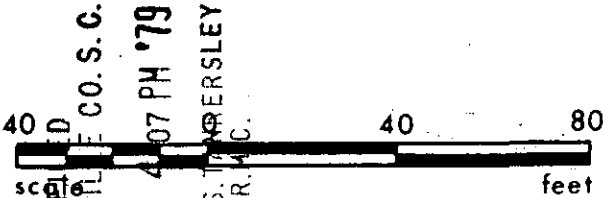

T 29.5-1-55



SEAL

**STATE OF SOUTH CAROLINA
GREENVILLE COUNTY**

EDWARDS FOREST HEIGHTS

LOT 55

PROPERTY OF

**DANA R. HALL &
SANDRA G. HALL**

FREELAND & ASSOCIATES Engineers • Land Surveyors	
GREENVILLE, S.C.	
SURVEY	L T
DRAWN	JRF
CHECK	M. C.
SCALE	1" = 40'
DATE	7-18-79
DWG. NO.	79-3700