


This is to certify that on July 17, 1979, I surveyed the property shown on this Plat, known as Lot 129 & Part Lot 128 on Plat of Westcliffe, Section 3, recorded in the RMC Office of Greenville County in Plat book JJJ on pages 72 and 73, and that the property lines, walls and buildings are as shown hereon; that the building located on said lot does not encroach or project on adjacent streets or property, and that no adjacent walls or buildings encroach or project on said premises, and that no utility lines cross this property except as shown hereon. This house is not located in a designated flood hazard area.

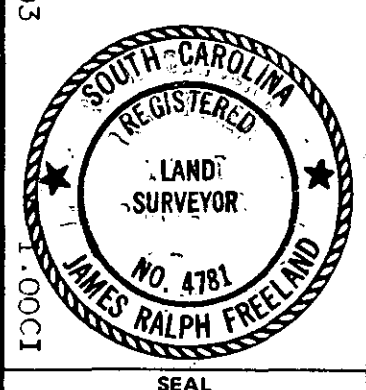

James R. Freeland
 James R. Freeland PLS & PE 4781
 JUL 23 1979
 7-J-77

FILED
 GREENVILLE CO. S.C.
 JUL 23 11 22 AM '79
 DONNA S. TANKERSLEY
 R.M.C.



STATE OF SOUTH CAROLINA
GREENVILLE COUNTY
 WESTCLIFFE
 SEC. 3 - LOT 129 & PT. 128
 PROPERTY OF
 JACK G. SCRUGGS

FREELAND & ASSOCIATES
 Engineers • Land Surveyors
 GREENVILLE, S.C.
 SURVEY D.G.
 DRAWN S.P.
 CHECK *ML*
 SCALE 1" = 50'
 DATE 7-17-79
 DWG. NO. 79-3696