


MICROFILMED

NOTE: Improvements on this lot are not in a flood hazard area.

FILED
GREENVILLE CO. S.C.
AUG 2 9 45 AM '79
DONNIE S. TANKERSLEY
R.M.C.

HAWKINS AVE.

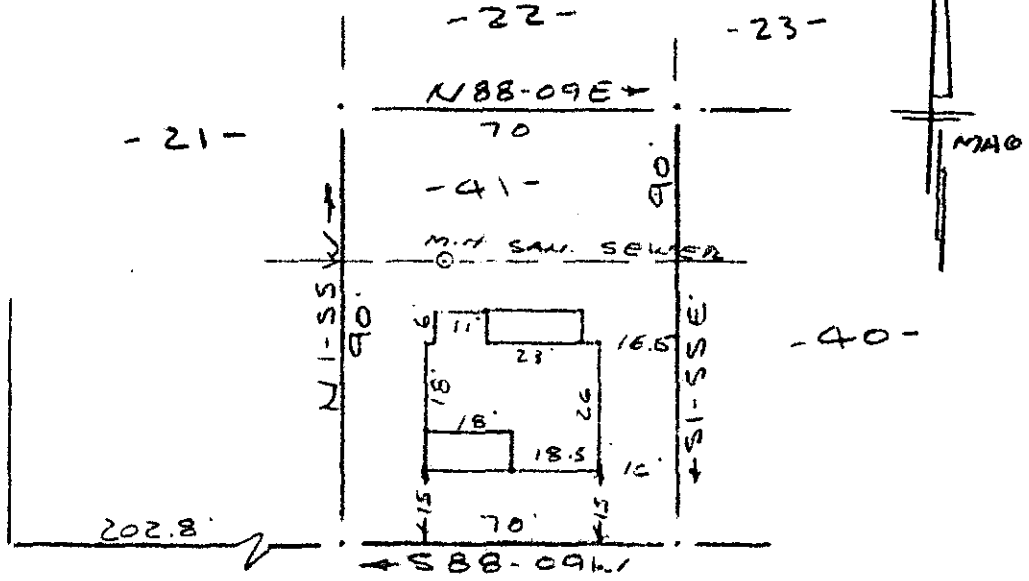

TENTH STREET
WATER IN ST R/W

PROPERTY OF
ROGER D. BLACKSTONE & FREIDA E. BLACKSTONE
NEAR GREENVILLE, S.C.
SCALE: 1" = 40' 31 JULY 1979

This is to certify that on the 31st day of July, 1979, I surveyed the property shown on this plat, being known as lot 41 on plat of JUDSON HILL VILLAGE and recorded in the REC Office Greenville County, S. C., in Plat Book "K" at Page 33; and that the property lines, walls and buildings are as shown hereon, and that the walls and buildings located on said lot do not encroach or project on adjacent street or property, and that no adjacent walls or buildings encroach or project on said premises, and no power lines cross this property except as shown hereon.

✓ 7M-8

4119

R. B. Bruce
R. B. Bruce, Surveyor

AUG 2 1979

CAROLINA SURVEYING CO.
112 Manly St.
Greenville, S. C.

