AF 10505

MICROFILMED

This is to certify that on August 1, 1979, I surveyed the property shown on this plat, known as Pt. Lot 22 on plat of Talmer Cordell Property, recorded in the RMC Office of Greenville County in Plat Book AA on page 33, and that the property lines, walls and buildings are as shown hereon; that the building located on said lot does not encroach or project on adjacent streets or property, and that no adjacent walls or buildings encroach or project on said premises, and that no utility lines cross this property except as shown hereon. This property is not located in a designated flood hazard area.

James R. Freeland

James R. Freeland RLS & PE 4781

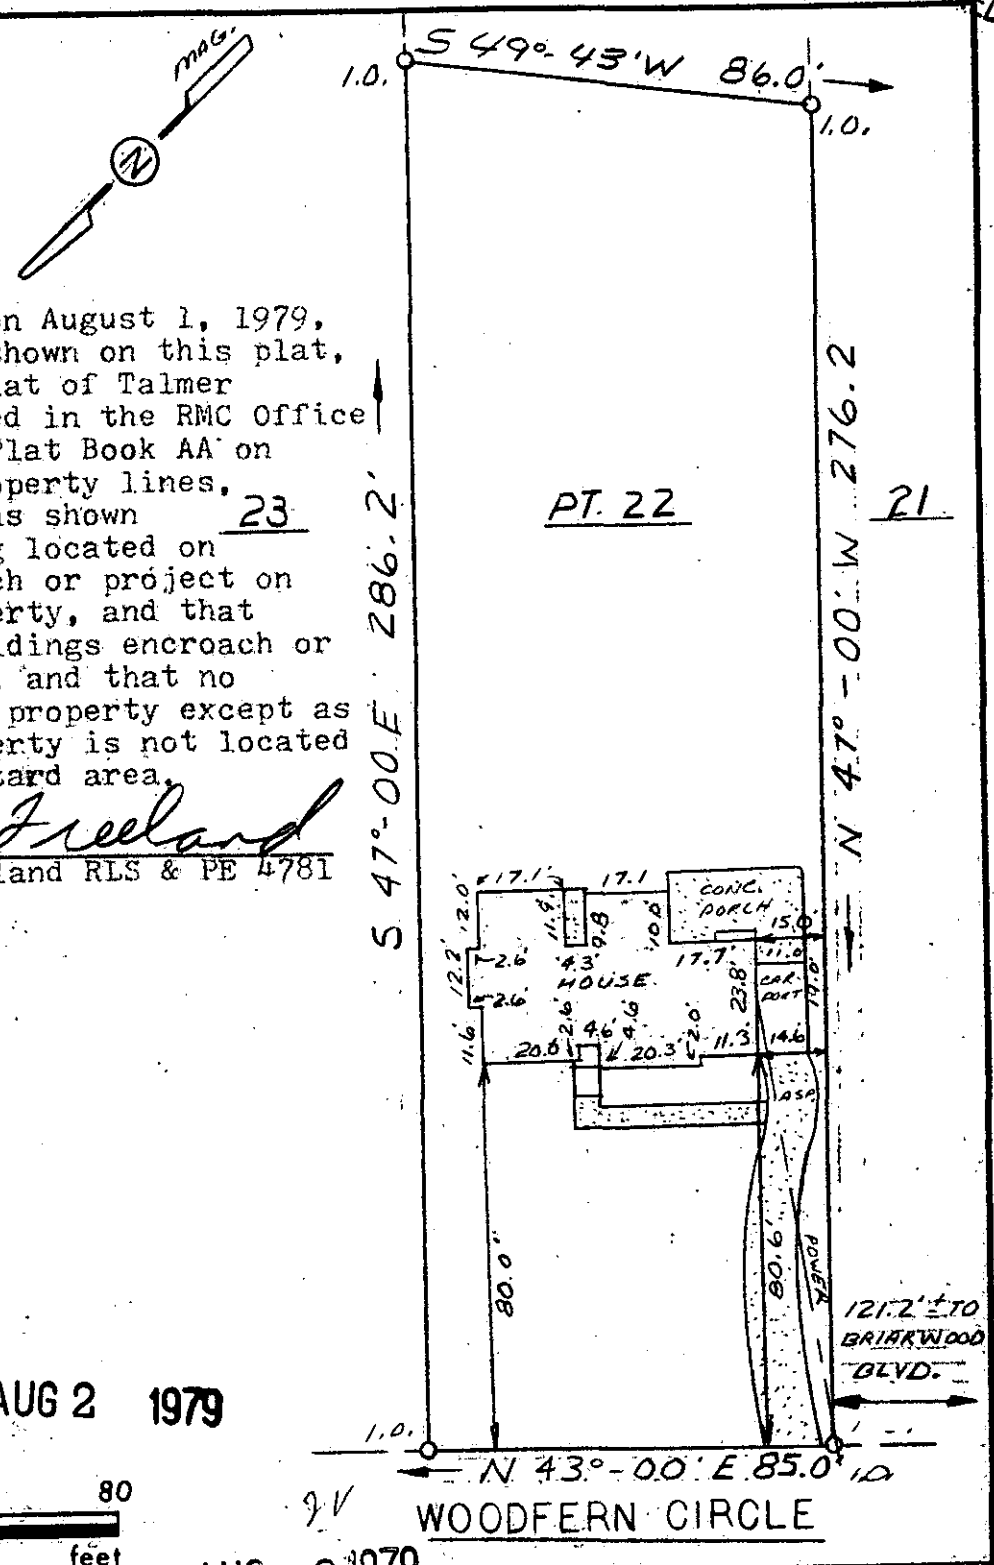

FILED
GREENVILLE CO. S.C.
AUG 2 11 42 AM '79
DONNIE S. TANKERSLEY
R.M.C.

7-M-11

AUG 2 1979

4122

GCTC --- 1 AUG 2 '79 626

3.00CI

SOUTH CAROLINA REGISTERED LAND SURVEYOR NO. 4781 JAMES RALPH FREELAND

SEAL

STATE OF SOUTH CAROLINA
GREENVILLE COUNTY

TALMER CORDELL PROPERTY
PT. LOT 22
PROPERTY OF
JOHN T. MOLL

FREELAND & ASSOCIATES
Engineers • Land Surveyors
GREENVILLE, S.C.

SURVEY	J.A.
DRAWN	S.R.
CHECK	M.C.
SCALE	1" = 40'
DATE	8-1-79
DWG. NO.	79-3787