


MICROFILMED

413

414

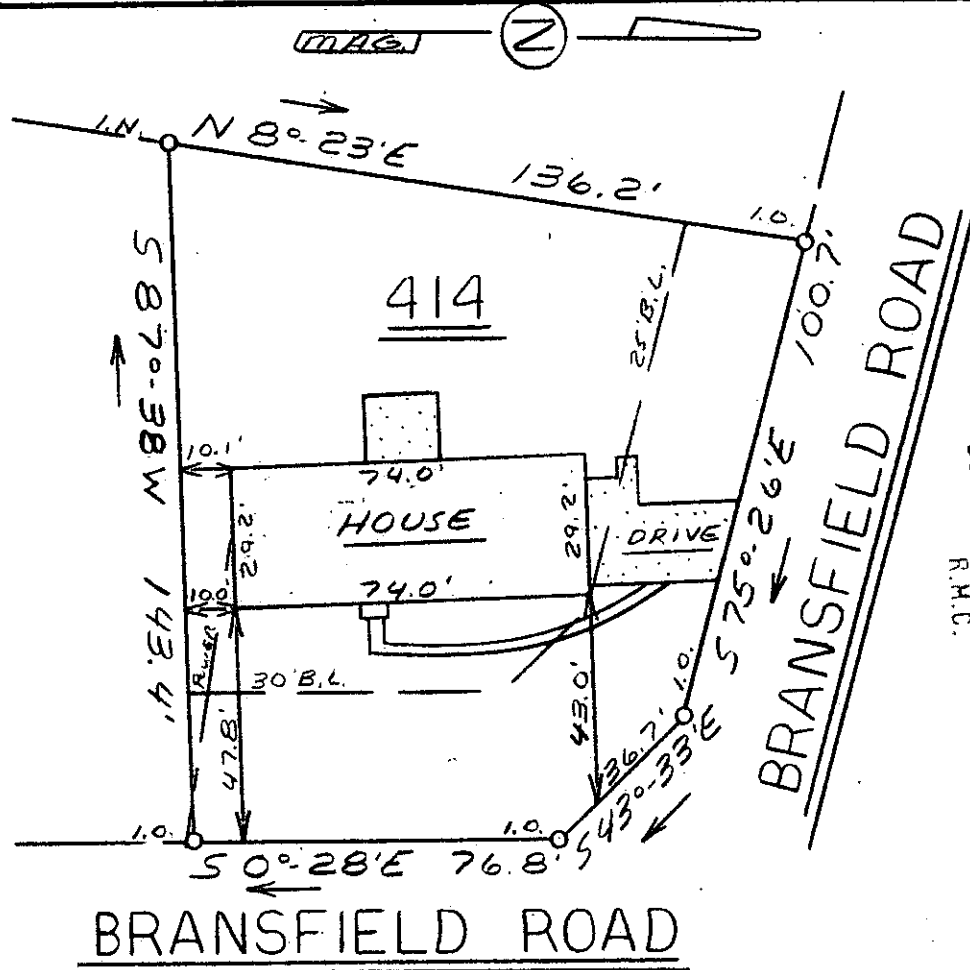

FILED
 GREENVILLE CO. S.C.
 AUG 6 3 25 PM '79
 DONNIE S. JANKERSLEY
 R.M.C.

BRANSFIELD ROAD

This is to certify that on August 2, 1979, I surveyed the property shown on this plat, known as Revision of Lot 414, Del Norte Estates, Section 5, recorded in the RMC Office of Greenville County in Plat Book 5G on Page 53, and that the property lines, walls and buildings are as shown hereon; that the building located on said lot does not encroach or project on adjacent streets or property, and that no adjacent walls or buildings encroach or project on said premises, and that no utility lines cross this property except as shown hereon. This property is located in a designated flood hazard area.

4401

5' drainage & utility easement
 each side of all side & rear
 lot lines.

James R. Freeland
 James R. Freeland RLS & PE 4781



7-M-23

AUG 6 1979



STATE OF SOUTH CAROLINA
GREENVILLE COUNTY

FREELAND & ASSOCIATES
 Engineers • Land Surveyors

GREENVILLE, S.C.

DEL NORTE ESTATES

SEC. 5 - LOT 414

PROPERTY OF
JAMES S. RUTH

M. ALEATH G. RUTH.

SURVEY	J.A.
DRAWN	M.C.
CHECK	VBHE
SCALE	1" = 40'
DATE	8-2-79
DWG. NO.	79-3800