


MICROFILMED

MEADORS AVENUE
WATER IN ST RW

N 81-44 E

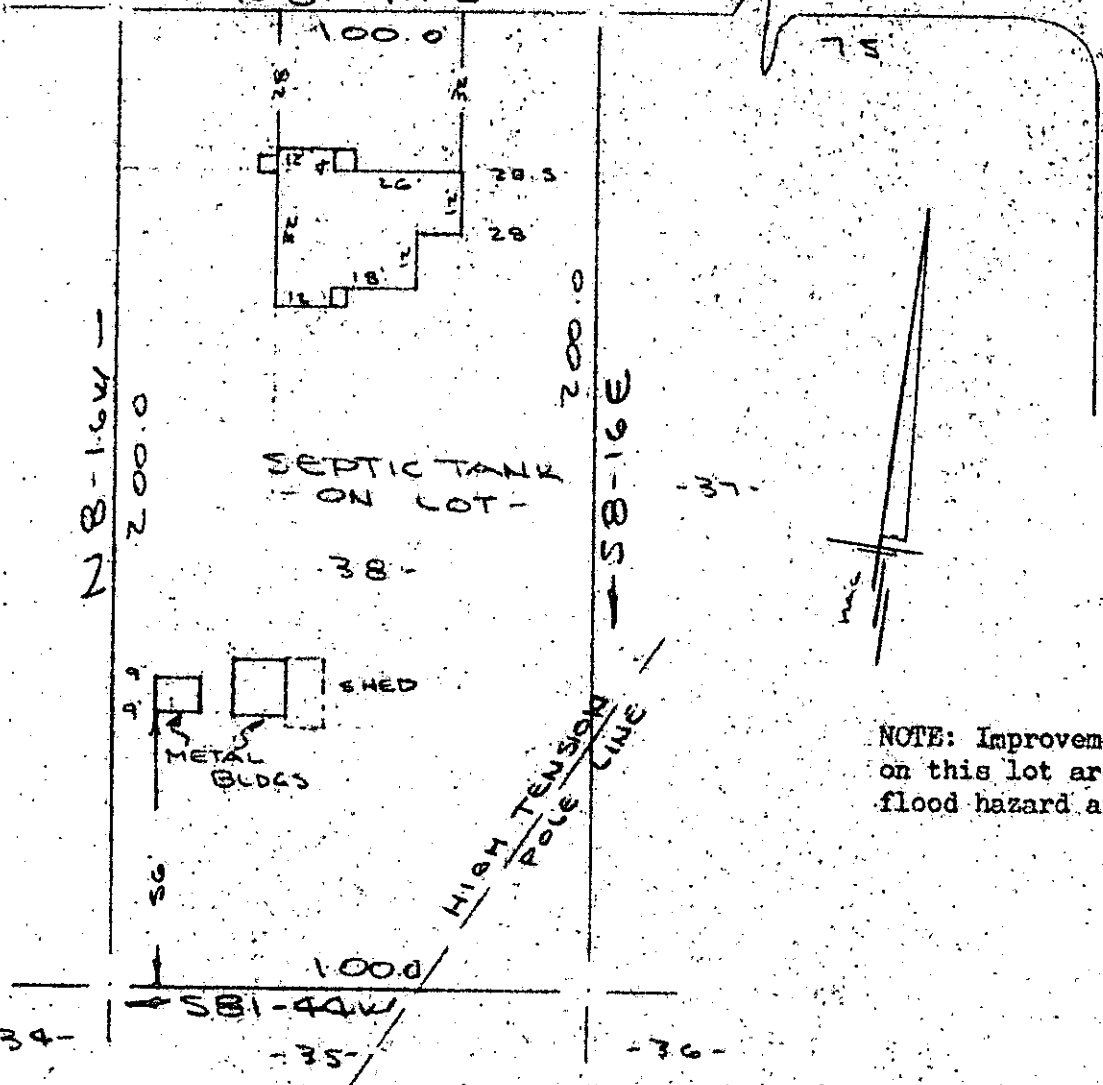

FILED
GREENVILLE CO. S.C.
AUG 16 4 29 PM '79
DONNIE S. TANKERSLEY
R.M.C.

NOTE: Improvements on this on this lot are not in a flood hazard area.

PROPERTY OF
BARRY E. GREEN & GEORGIA L. GREEN
NEAR GREENVILLE, S.C.
SCALE 1" = 40' JUNE 1979

This is to certify that on the 7th day of June, 1979, I surveyed the property shown on this plat, being known as lot 38 on plat of AUGUSTA ACRES and recorded in the RMC Office Greenville County, S. C., in Plat Book " S " at Page 201; and that the property lines, walls and buildings are as shown hereon, and that the walls and buildings located on said lot do not encroach or project on adjacent street or property, and that no adjacent walls or buildings encroach or project on said premises, and no power lines cross this property except as shown hereon.

7M-64 ✓
AUG 16 1979

5676

R. B. Bruce
R. B. Bruce, RLS 1952

CAROLINA SURVEYING CO.
112 Manly St.
Greenville, S. C. 29615

300 A4

212 @ 35 391-2-70