


MICROFILMED

FILED
GREENVILLE CO. S. C.

AUG 24 10 50 AM '79

DONNIE S. TANKERSLEY
R.M.C.

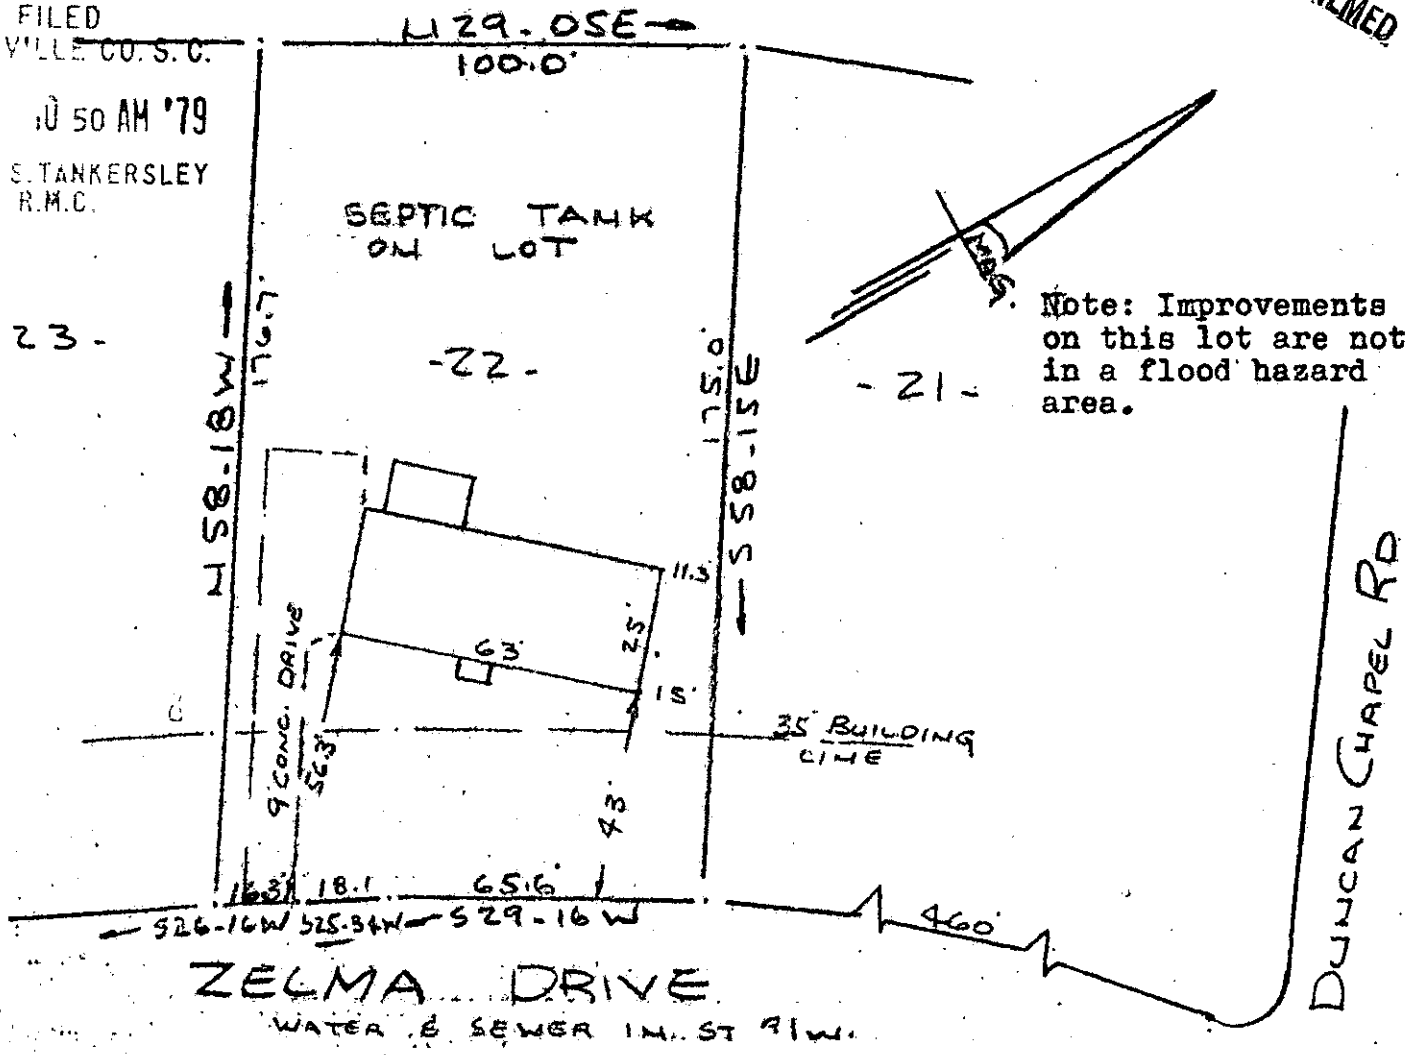

PROPERTY OF
ROBERT N. JENKINS
 NEAR GREENVILLE, S. C.
 SCALE 1" = 40' 22 AUG 1979


This is to certify that on the 22nd day of August, 1979, I surveyed the property shown on this plat, being known as lot 22 on plat of OAKLAND TERRACE and recorded in the RMC Office Greenville County, S. C., in Plat Book "BB" at Page 196 and also Revision of lots 22 & 23 shown on Plat Book "5 - M" at Page 59 also being known as PROPERTY OF ROBERT N. JENKINS and recorded in Plat Book at Page ; and that the property lines, walls and buildings are as shown hereon, and that the walls and buildings located on said lot do not encroach or project on adjacent street or property, and that no adjacent walls or buildings encroach or project on said premises, and no power lines cross this property except as shown hereon.

6739

R. B. Bruce
 R. B. Bruce, PLS. #1952

AUG 24 1979

CAROLINA SURVEYING CO.
 112 Manly St.
 Greenville, S. C.

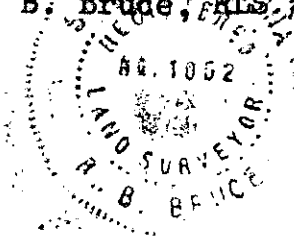

7M-90

GCTO
3.00CI