


MICROFILMED

FILED
GREENVILLE CO. S. C.
AUG 27 12 01 PM '79
DONNIE S. TANKERSLEY
R.M.C.

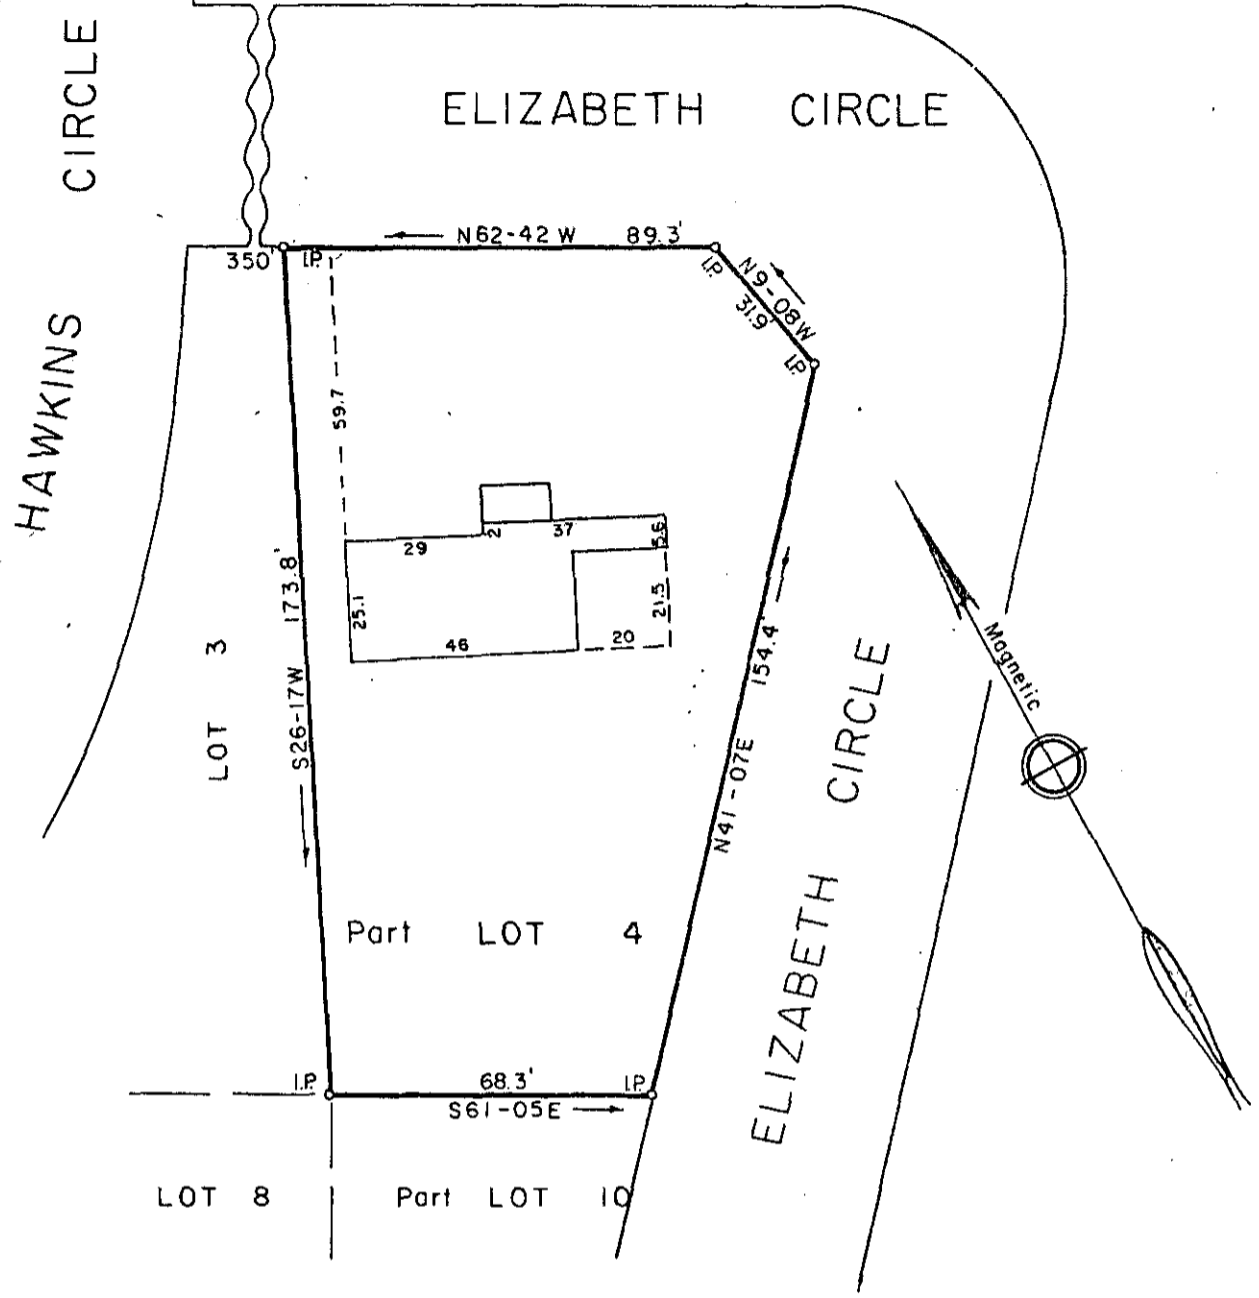

PROPERTY OF

DENNIS RAY DAY ✓
BRENDA O. DAY

6918

7-M-96

GREENVILLE CO., S. C.

Scale 1" = 40' July, 1979

This is to certify that on the 20th day of July, 1979, We surveyed the property shown on this plat; being known as Part Lot 4 on plat of Bobby L. Hawkins, Recorded in Plat Book HHH page 77, Office of R.M.C. Greenville Co., S.C.; and that the property lines, walls and buildings are as shown hereon; that the buildings located on said lot do not encroach or project on adjacent streets or property; and that no adjacent buildings or walls encroach or project on said premises; and from information from Greenville County, this structure is not in a designated flood area.



Dalton & Neves Co., Engineers

GCTO --- 1 AU27 79 1276

3 00CT