


MICROFILMED



FILED
GREENVILLE CO. S.C.
AUG 30 4 09 PM '79
DONNIE S. TANKERSLEY
R.M.C.

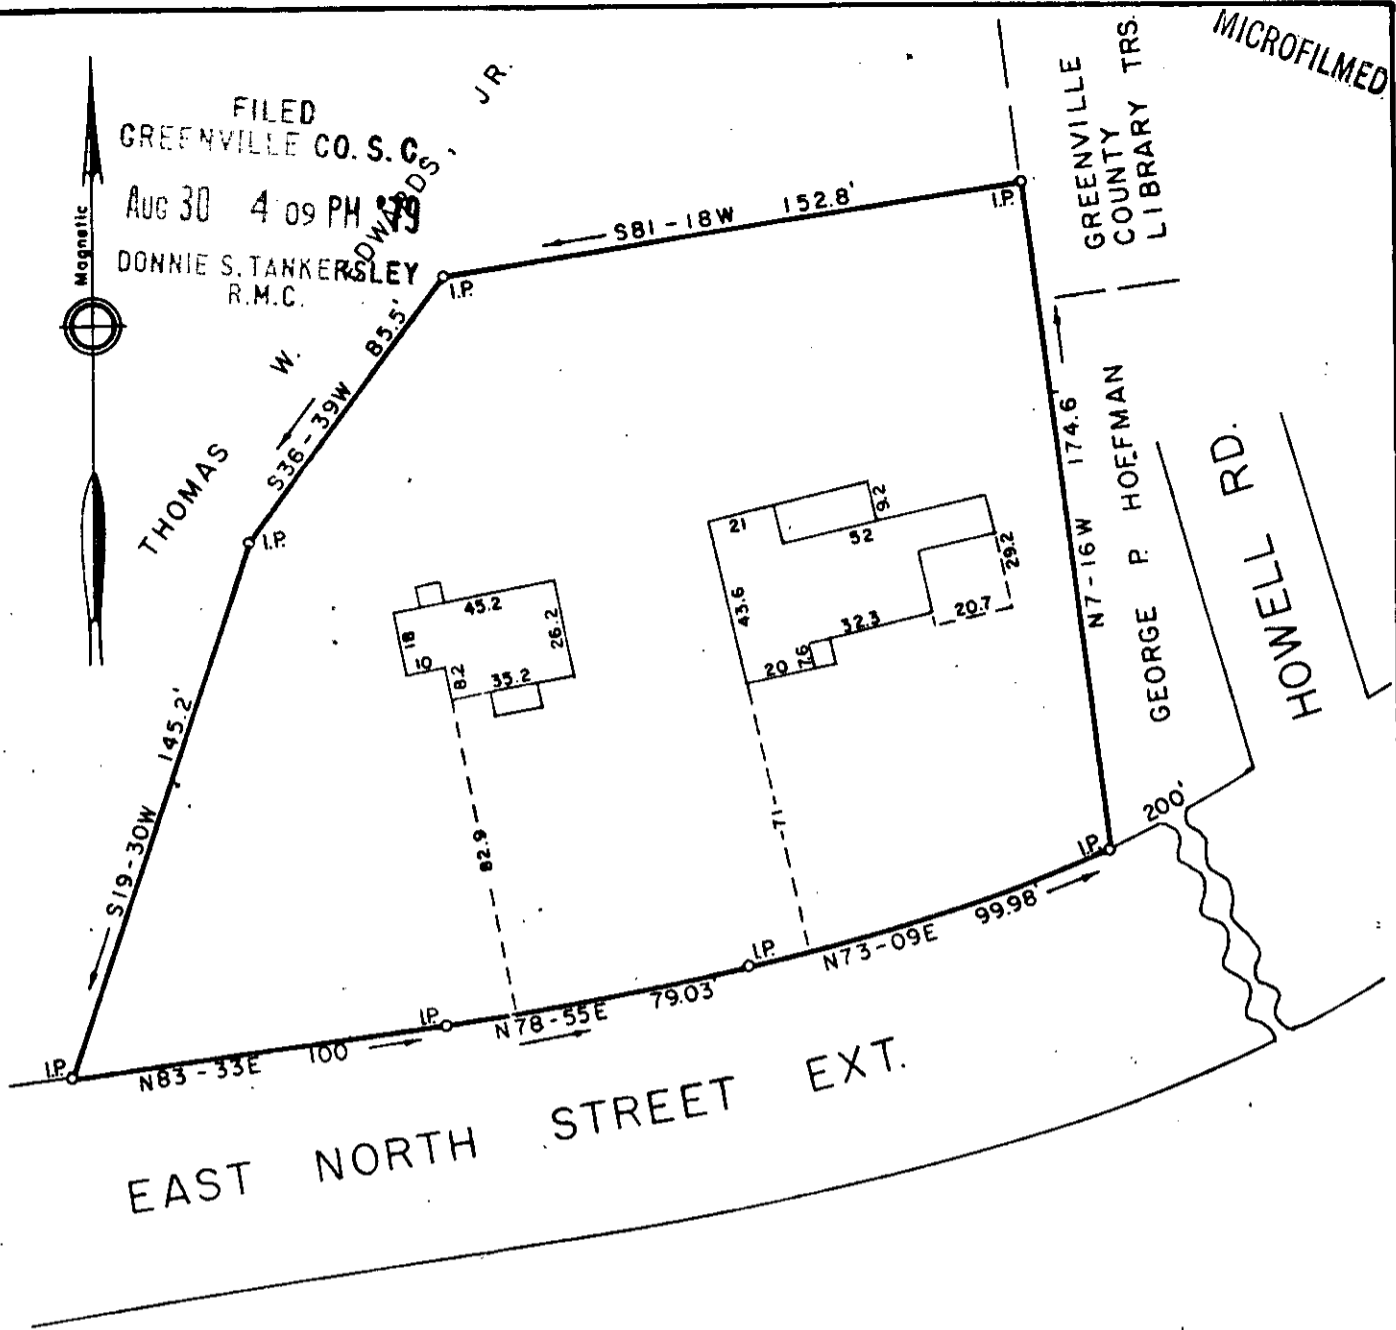

PROPERTY OF
JOSEPH O. HAWKINS
GREENVILLE CO., S.C.

Scale 1" = 50' August, 1979

This is to certify that on the 29th day of August, 1979, We surveyed the property shown on this plat; being shown on plat of Joseph O. Hawkins, Recorded in Plat Book _____, page _____, Office of R. M. C. Greenville Co., S. C.; and that the property lines, walls and buildings are as shown hereon; that the buildings located on said property do not encroach or project on adjacent streets or property; and that no adjacent buildings or walls encroach or project on said premises; and from information from Greenville County, this structure is not in a designated flood area.

7392

7-N-9 AUG 30 1979

William B. Funt
DALTON & NEVES CO., ENGINEERS

