


FILED  
GREENVILLE CO. S. C.


MICROFILMED

SEP 12 1 53 PM '79  
DONNIE S. TANKERSLEY  
R.M.C.

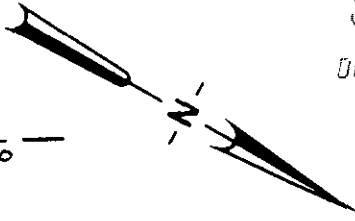

This is to certify that on August 30, 1979, I surveyed the property shown on this plat, known as Lot 5 on plat of Pinehurst Subdivision Sec. A, recorded in the RMC Office of Greenville County in Plat Book 3 on page 77A, and that the property lines, walls and buildings are as shown hereon; that the building located on said lot does not encroach or project on adjacent streets or property, and that no adjacent walls or buildings encroach or project on said premises, and that no utility lines cross this property except as shown hereon. This property is not located in a designated flood hazard area.

*James R. Freeland*  
James R. Freeland RLS & PE 4781

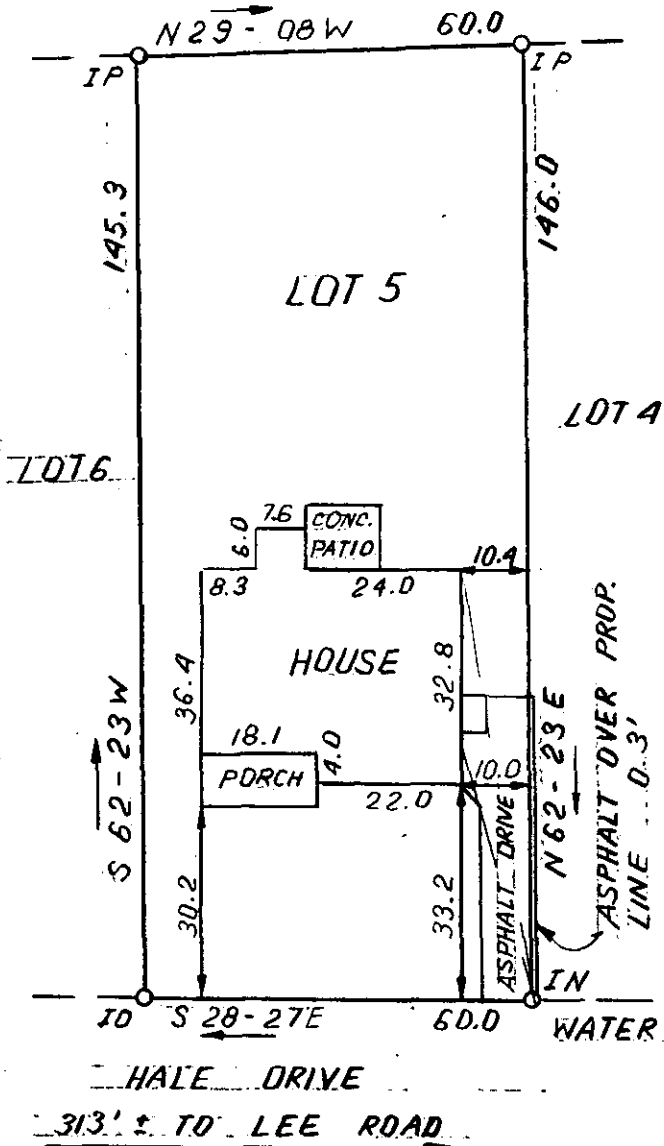

8752

✓ 7N-43

SEP 12 1979



P15.6-1-5



STATE OF SOUTH CAROLINA  
GREENVILLE COUNTY

PINEHURST SUB.  
LOT 5, SECT. A  
PROPERTY OF  
FRANK S. GAINES &  
SUE H. GAINES

FREELAND & ASSOCIATES  
Engineers • Land Surveyors

GREENVILLE, S.C.

SURVEY LES
DRAWN B.R.
CHECK <i>MC</i>
SCALE 1" = 30'
DATE AUG. 30. 79
DWG. NO. 79-3972

GCTO --- 1 SE12 79 1041

3.00CI