


MICROFILMED

FILED
GREENVILLE CO. S. C.

SEP 13 4 22 PM '79


211.9'

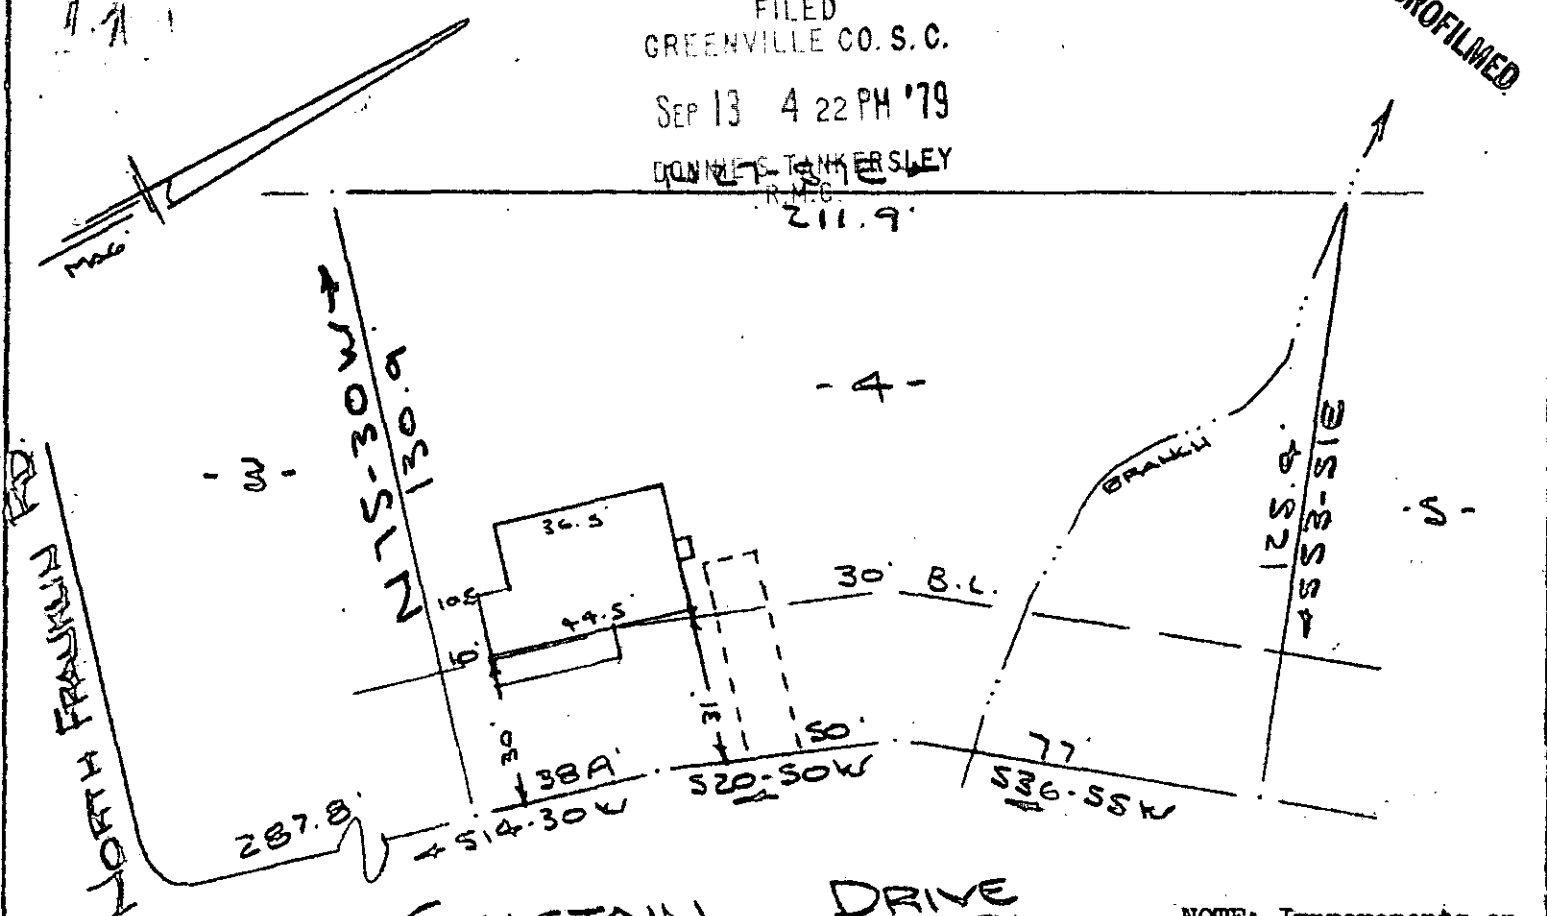

CHASTAIN DRIVE
WATER & SEWER IN ST RW

NOTE: Improvements on this lot is in a flood hazard area.

PROPERTY OF
REBEKAH ANITA HENDRICKS
NEAR GREENVILLE, S.C.
SCALE: 1" = 40'
9 SEPT. 1979

This is to certify that on the 9th day of September, 1979, I surveyed the property shown on this plat, being known as lot 4 on plat of MAPLE ACRES and recorded in the RMC Office Greenville County, S. C., in Plat Book "FF" at Page 111 and also being known as PROPERTY OF REBEKAH ANITA HENDRICKS and recorded in the RMC Office in Plat Book 7N at Page 46; and that the property lines, walls and buildings are as shown hereon, and that the walls and buildings located on said lot do not encroach or project on adjacent street or property, and that no adjacent walls or buildings encroach or project on said premises, and no power lines cross this property except as shown hereon.

7-N-46

R. B. Bruce

R. B. Bruce, RIS #1952

8908

CAROLINA SURVEYING CO.
GCTO 112-2 8/14/79 81141
Greenville, S. C.

