


MICROFILMED

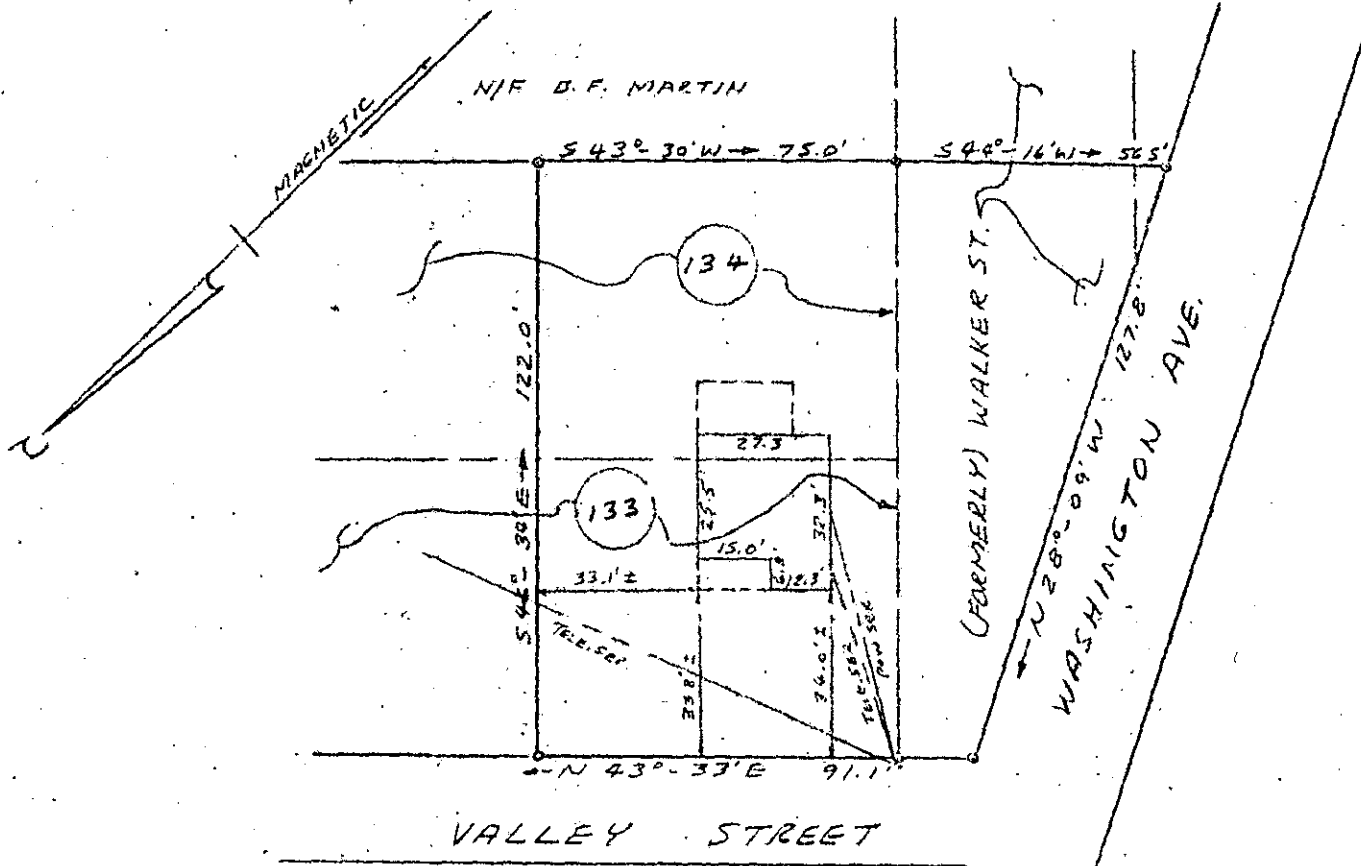

PROPERTY OF
MARVIN T. SIMMONS
GREENVILLE, SOUTH CAROLINA
SEPT. 19, 1979 SCALE: 1"=40'

GCTO
SE 28 79
1 322

This is to certify that on September 19, 1979, I surveyed the property shown on this plat, known as part of lots 133 and 134, part of a strip formerly known as Walker Street and a part of a tract of land on the southern side of the strip formerly known as Walker Street between Walker Street and Washington Avenue, as shown on a plat recorded in the RMC Office for Greenville County of Westview Heights, Plat Book G, page 33, and that the property lines, walls and buildings are as shown hereon, and that the building located on said lot does not project nor encroach on adjacent streets or property, and that no adjacent walls or buildings project nor encroach on said lot, and that no utility lines cross this property except as may be shown hereon.

NOTE: This property is not located within a flood hazard area.

Survey by: Richard D. Wooten, Jr.
 Greenville, South Carolina

10835

SOUTH CAROLINA
 REGISTRY
Richard D. Wooten, Jr.
 S.C. L.S. No. 4678
 RICHARD D. WOOTEN, JR.
 SURVEYOR

✓
 69-N-7

SEP 28 4 19 PM '79
 DONNIE S. TANKERSLEY
 R.M.C.

676182 PES

GREENVILLE CO. S.C.

3.00CI