


MICROFILMED

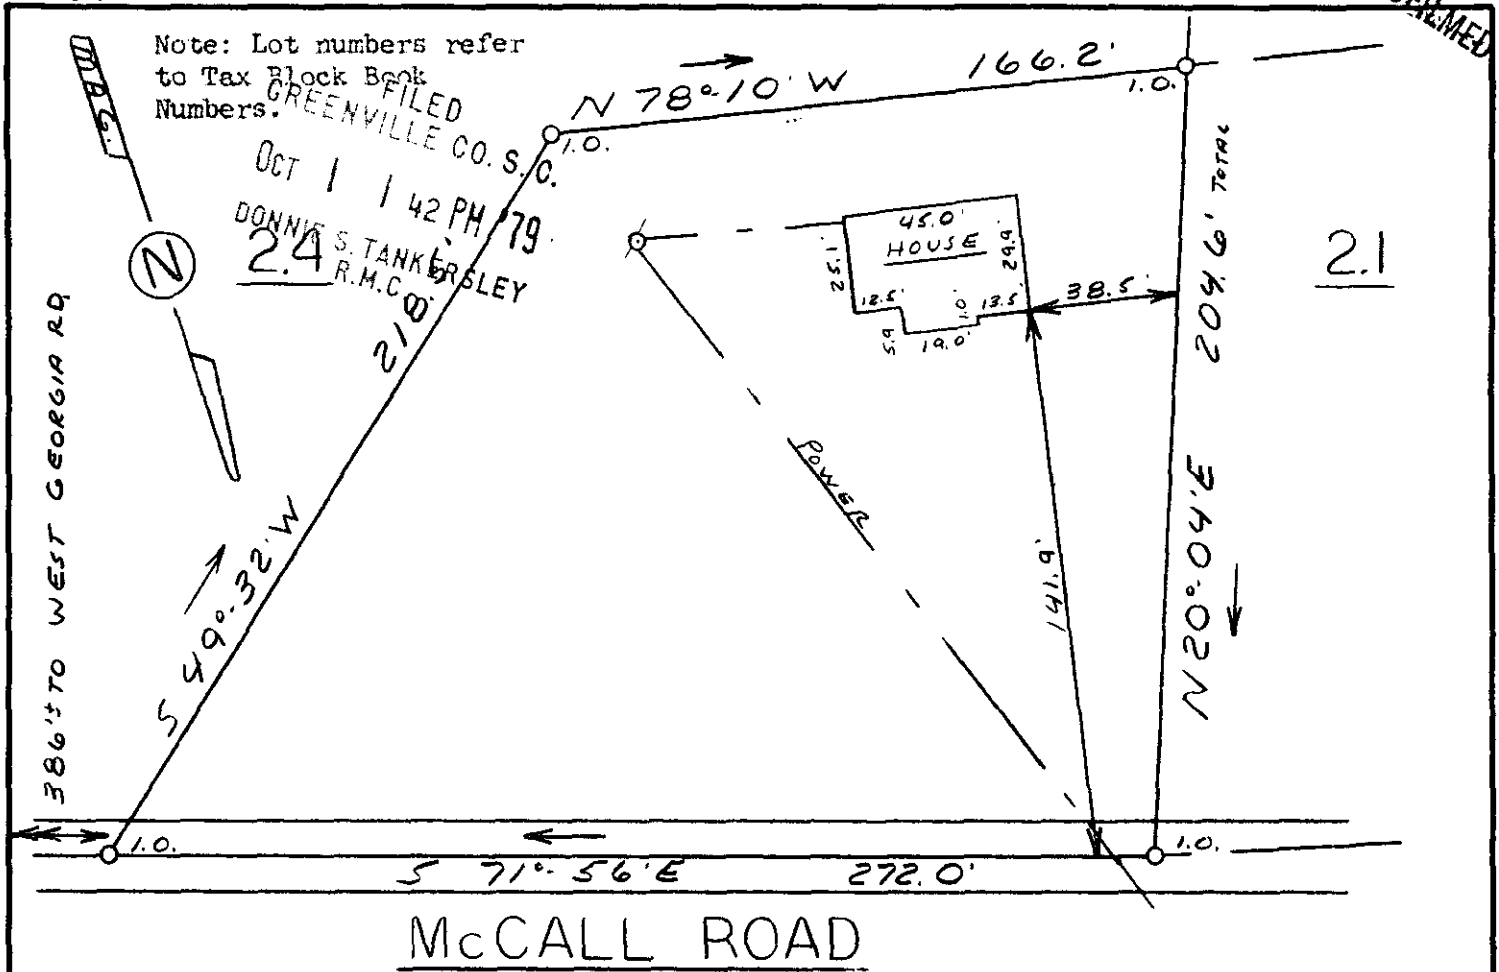

This is to certify that on September 26, 1979, I surveyed the property shown on this plat, known as Property of Rita T. Cook, recorded in the RMC Office of Greenville County in Deed Book 1103 on page 215, and that the property lines, walls and buildings are as shown hereon; that the building located on said lot does not encroach or project on adjacent streets or property, and that no adjacent walls or buildings encroach or project on said premises, and that no utility lines cross this property except as shown hereon. This property is not located in a designated flood hazard area.

11052 ✓ James R. Freeland
James R. Freeland RLS & PE 4781

2R-3

OCT 1 1979



574.3 - 1-1



SEAL

STATE OF SOUTH CAROLINA
GREENVILLE COUNTY

PROPERTY OF
A.H. McKEOWN, SR.

LOTTIE L. McKEOWN

FREELAND & ASSOCIATES
Engineers • Land Surveyors
GREENVILLE, S.C.

SURVEY	D.H.
DRAWN	M.C.
CHECK	M.C.
SCALE	1" = 50'
DATE	9-26-79
DWG. NO.	79-4104