


MICROFILMED

FILED
GREENVILLE CO. S.C.
OCT 1 2 15 PM '79
DONNIE S. TANKERSLEY
R.M.C.

MAG.

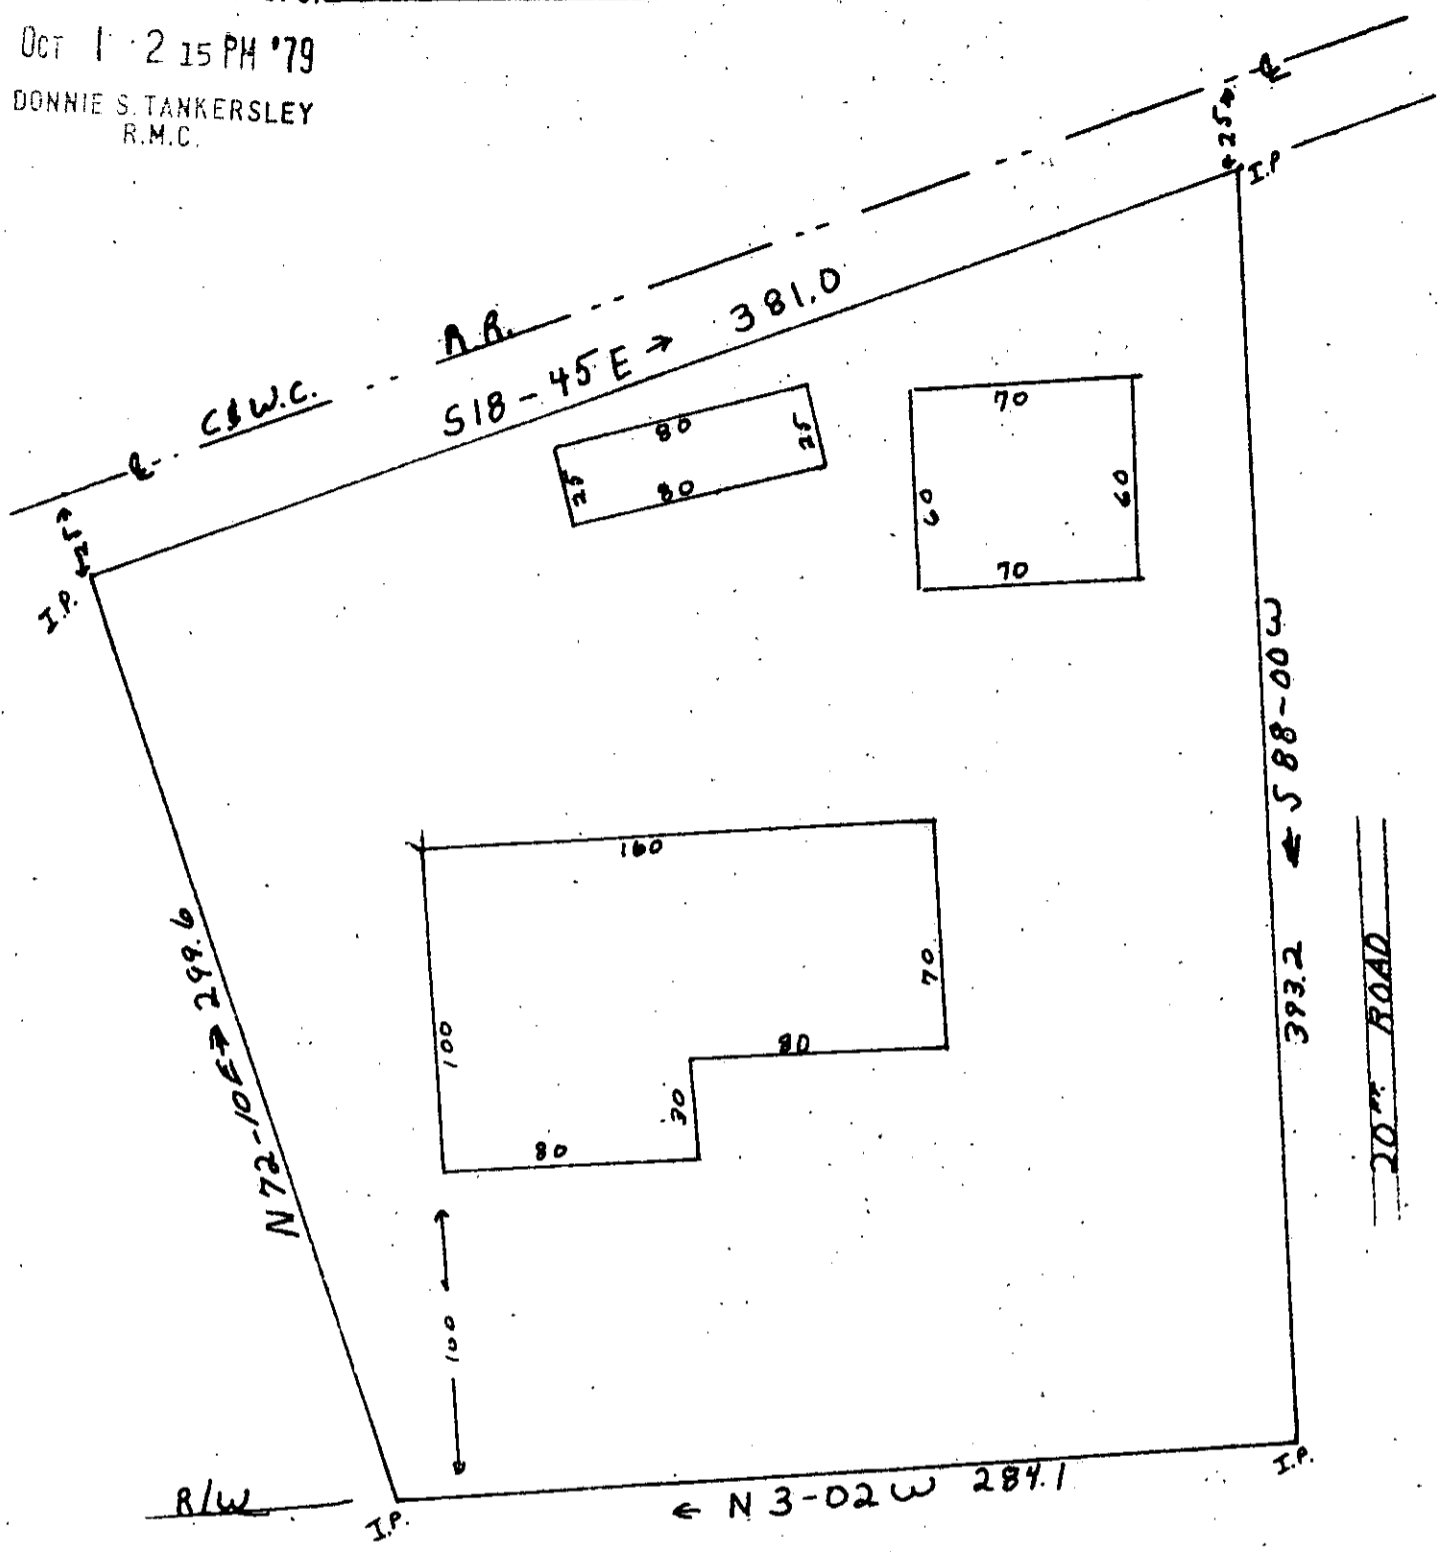

LAURENS ROAD

11056 U.S. HWY. 276

I hereby certify that on Sept. 24, 1979 I rechecked the above plat according to a previous survey, and that the property lines buildings and walls are as shown hereon, that no walls or buildings encroach or project on adjacent streets or property and no buildings or walls encroach or project on these premises, and that the structures are not within a flood hazard area.

PROPERTY OF
GOLDEN STRIP MOTORS INC.
 IN THE TOWN OF MAULDIN
 GREENVILLE COUNTY S.C.
 WEBB SURVEYING & MAPPING CO.
 SCALE 1" = 60' SEPT. 1979

Charles F. Webb
 Charles F. Webb, R.L.S.
 REGISTERED
 1377
 1979

OCT 1 1979
 7-R-4

THIS PLAT FOR RECORDING

BLK. BK. REF. M2.1-1-1