MICROFILMED

FILED
GREENVILLE CO. S. C.
OCT 8 3 50 PM '79
DONNIE S. TANKERSLEY
R.M.C.

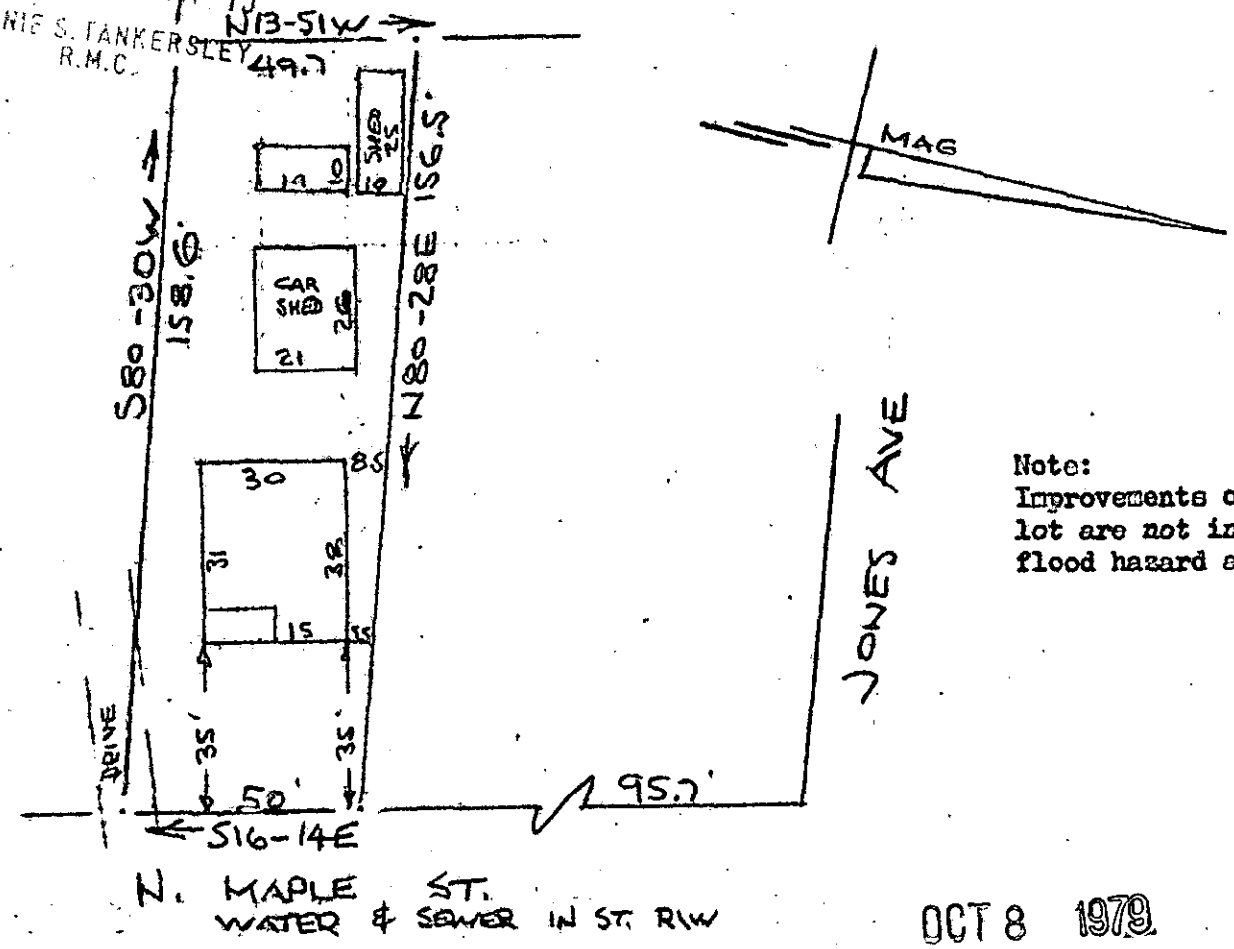

Note:
Improvements on this lot are not in a flood hazard area.

OCT 8 1979

PROPERTY OF
CHARLES W. CLODFELTER & PATRICIA J. CLODFELTER
SIMPSONVILLE, S. C.
SCALE: 1" = 40' 10CT1979

GCTO ----- 3 OC 8/79 556

This is to certify that on the 1st day of October, 1979, I surveyed the property shown on this plat, being known as PROPERTY OF CHARLES W. CLODFELTER & PATRICIA J. CLODFELTER and recorded in the RMC Office Greenville County, S. C., in Plat Book at Page and that the property lines, walls and buildings are as shown hereon, and that the walls and buildings located on said lot do not encroach or project on adjacent street or property, and that no adjacent walls or buildings encroach or project on said premises, and no power lines cross this property except as shown hereon.

7-R- 33

R. B. Bruce

R. B. Bruce, RLS #1952

11819

CAROLINA SURVEYING CO.
112 Manly St.
Greenville, S. C.

3.00CI

211151 307-6-2