

OCT 11 4 04 PM '79

MICROFILMED

-59-

-58-

N51-0E → 116' TOT


10' DRAIN EASEMENT DONNIE S. TANKERSLEY R.M.C.

-77-

-78-

PT 79-

-PT. 79-

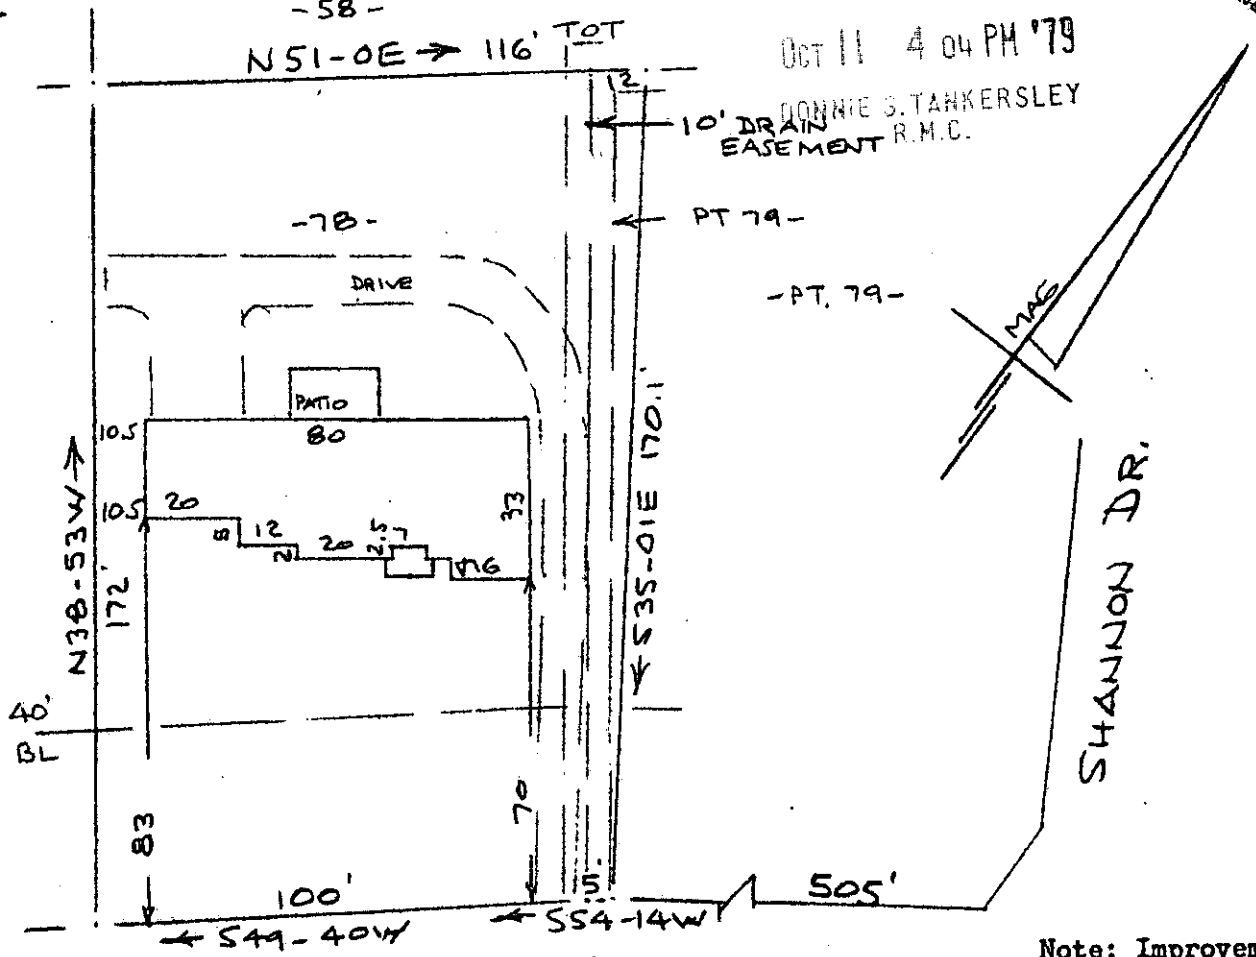

LAKE FAIRFIELD DR WATER & SEWER IN ST. R/W

Note: Improvements on this lot are not in a flood hazard area.

PROPERTY OF RICHARD L. SNYDER & BRENDA H. SNYDER NEAR GREENVILLE, S. C. SCALE: 1" = 40' 10 OCT 1979


GCTO ----- 3

This is to certify that on the 10th day of October, 1979, I surveyed the property shown on this plat, being known as lot 78 and part of lot 79 on plat of LAKE FOREST and recorded in the RMC Office Greenville County, S. C., in Plat Book "GG" at Page 17 and also being known as PROPERTY OF RICHARD L. SNYDER & BRENDA H. SNYDER and recorded in Plat Book at Page ; and that the property lines, walls and buildings are as shown hereon, and that the walls and buildings located on said lot do not encroach or project on adjacent street or property, and that no adjacent walls or buildings encroach or project on said premises, and no power lines cross this property except as shown hereon.

7-R-51 ✓

12260

R. B. Bruce, SLS 1752

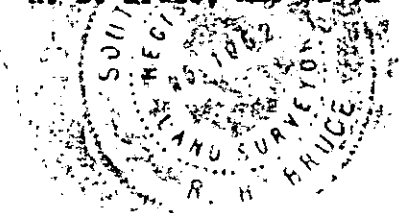

CAROLINA SURVEYING CO. 112 Manly St. Greenville, S. C.

3.0001