



MICROFILMED

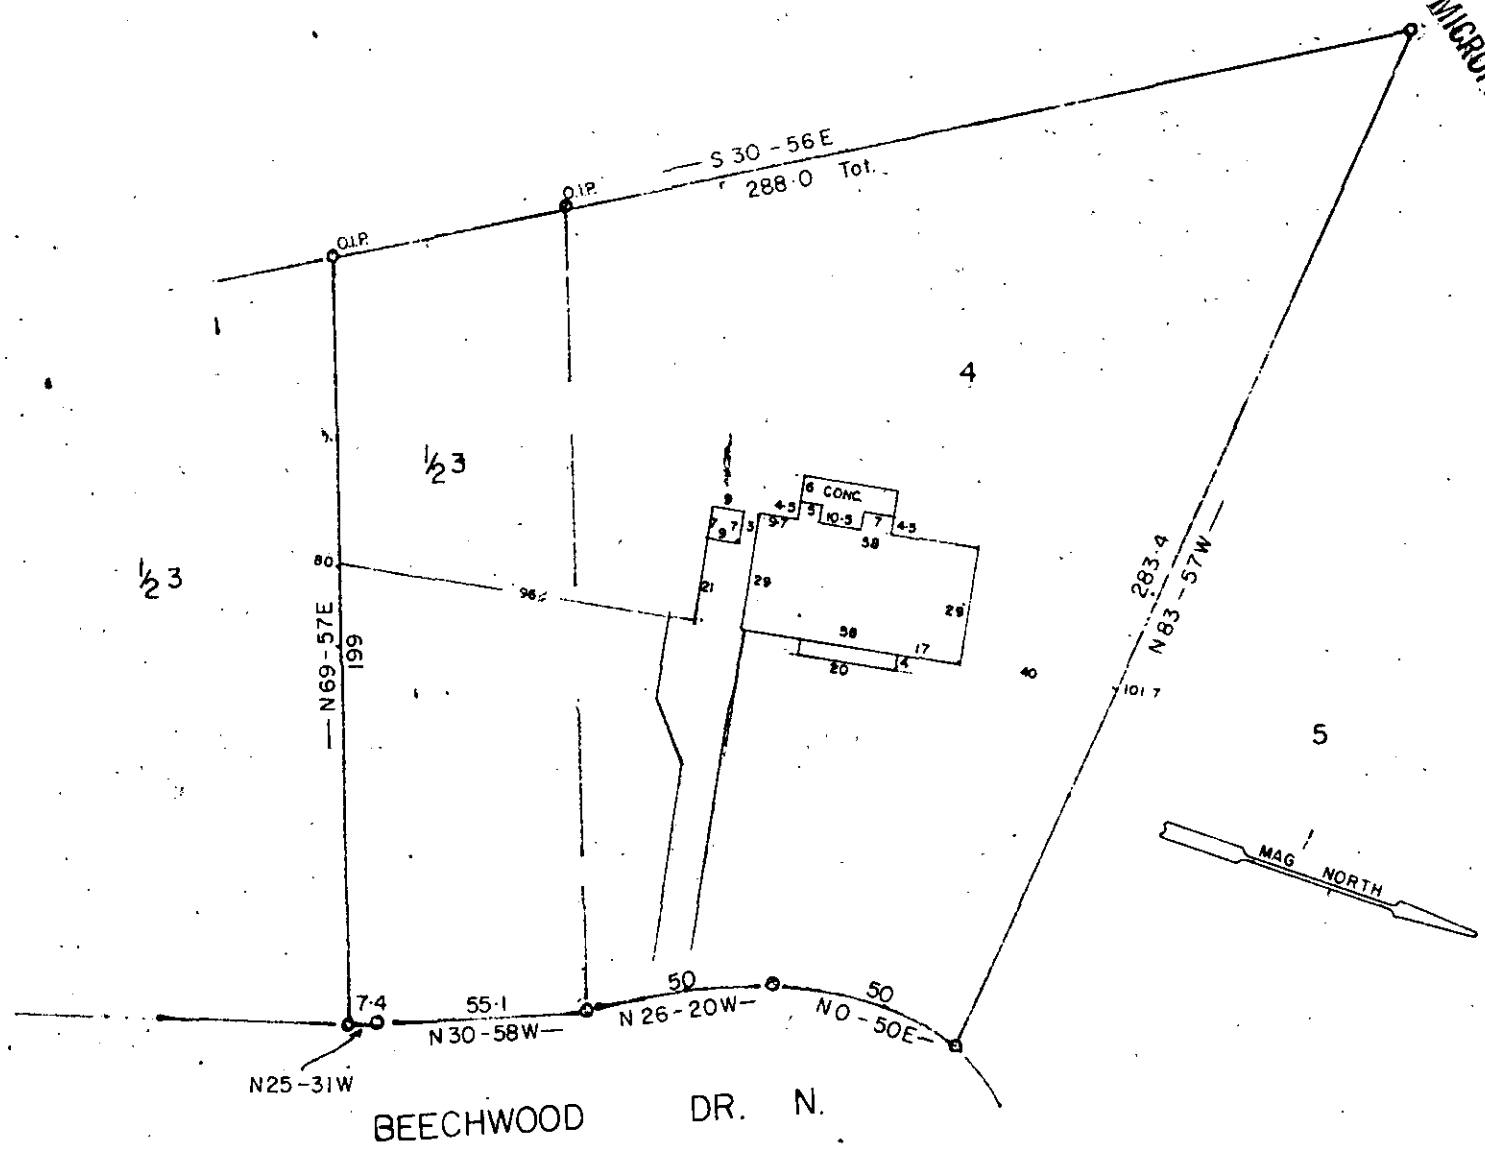

GCTO

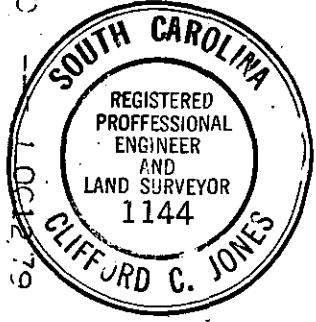

NOTE: This lot does not lie in a flood plane.

12441
7-R-53


PROPERTY OF

LOUIE T. INABINETT
OR
DONALD M. INABINETT

FILED
GREENVILLE CO., S.C.
OCT 12 3 38 PM '79
DONNIE S. TUCKERLEY
R.M.D.

NEAR SIMPSONVILLE, S. C.

SCALE 1" = 50' OCT - 3 - 79

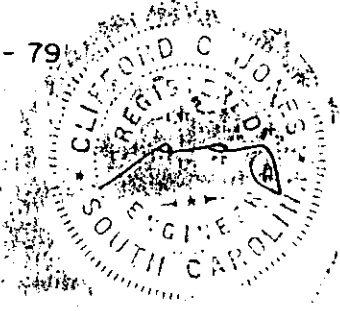

This is to certify that on the 3 day of OCT 1979, I surveyed the property shown on this plat, being LOT 4 1/2 3 BEECHWOOD HILLS, recorded in Plat Book 00 of the R.M.C. Office for Greenville County, S. C., and that the property lines, walls and buildings are as shown hereon; that the buildings located on said lot do not encroach or project on adjacent streets or property; and that no adjacent buildings or walls encroach or project on said premises, and that no utility lines cross this property.

[Signature]
Reg. Engineer No. 1144 S.C.